

CIVIL ENGINEERING PLANS FOR FIRST UNITED METHODIST CHURCH OF CELINA

FIRST UNITED METHODIST CHURCH ADDITION LOT 1, BLOCK A CITY OF CELINA, COLLIN COUNTY, TEXAS

SHEET INDEX


TITLE SHEET	T-1
FINAL PLAT	S-1
GENERAL NOTES	C-1
PHASE 1 SITE PLAN	C-2
OVERALL CONCEPTUAL SITE PLAN	C-3
GRADING PLAN	C-4
DRAINAGE AREA MAP	C-5
DRAINAGE PLAN	C-6
STORM SEWER PROFILES	C-7
UTILITY PLAN	C-8
SANITARY SEWER PROFILE	C-9
EROSION CONTROL PLAN	C-10
LANDSCAPE PLAN	L-1 THRU L-5

DETAILS & STANDARDS

MISCELLANEOUS DETAILS - PAVING	D-1
MISCELLANEOUS DETAILS - DRAINAGE	D-2 THRU D-4
MISCELLANEOUS DETAILS - EROSION CONTROL	D-5
MISCELLANEOUS DETAILS - UTILITY	D-6
MISCELLANEOUS DETAILS - THRUST BLOCK	D-7
SETP-PD	D-8
TCP(2-1)-12	D-9

GENERAL NOTES:

1. THE ENGINEERING PLANS ARE DESIGNED TO AND SHALL BE CONSTRUCTED TO THE CITY OF CELINA, COLLIN COUNTY, THE NORTH CENTRAL TEXAS COUNCIL OF GOVERNMENTS, AND TXDOT STANDARD DETAILS.
2. ALL EXISTING UTILITIES ARE SHOWN SCHEMATICALLY AND ARE FOR THE CONTRACTOR'S INFORMATION ONLY. THE CONTRACTOR SHALL VERIFY THE LOCATION SIZE, AND MATERIAL OF ALL UTILITIES AFFECTED BY CONSTRUCTION PRIOR TO COMMENCEMENT. THE CONTRACTOR SHALL CONTACT ALL AFFECTED UTILITIES 48 HOURS PRIOR TO CONSTRUCTION.
3. ALL CONTRACTORS SHALL CONFINE THEIR ACTIVITIES TO THE WORK AREA. NO ENCROACHMENTS ONTO DEVELOPED OR UNDEVELOPED AREAS WILL BE ALLOWED. ANY DAMAGE RESULTING THERE FROM SHALL BE THE CONTRACTOR'S RESPONSIBILITY TO REPAIR.
4. ALL CONSTRUCTION AND MATERIALS TESTING SHALL MEET OR EXCEED ALL REQUIREMENTS OF THE CITY OF CELINA AND/OR NCTCOG STANDARDS AND SPECIFICATIONS.

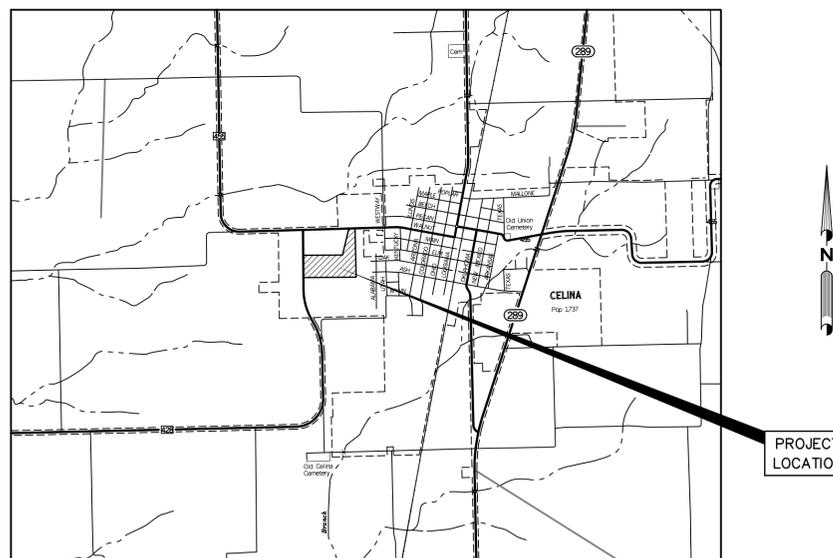

LOCATION MAP

PROJECT CONTROL DATA:

CITY OF CELINA BENCHMARK MONUMENT K263, LOCATED ON THE ELEVATED STORAGE TANK DOWNTOWN (OLD WATER TOWER).
ELEVATION = 695.44

TBM
60D NAIL SET IN POWER POLE APPROXIMATELY 18' SOUTH OF SOUTHWEST CORNER OF FIRST UNITED METHODIST CHURCH SITE.
ELEVATION = 674.26

TBM
60D NAIL SET IN POWER POLE APPROXIMATELY 309 FEET WEST OF NORTHEAST PROPERTY CORNER OF FIRST UNITED METHODIST CHURCH SITE.
ELEVATION = 692.20



1515 HERITAGE DRIVE, STE. 212
MCKINNEY, TEXAS 75069
P 972.569.9193 F 972.569.9197

TEXAS REGISTERED ENGINEERING FIRM NO. F-9356

CITY OF CELINA
ENGINEERING DEPARTMENT
RELEASED FOR CONSTRUCTION

DATE _____ BY _____


PRIOR TO CONSTRUCTION, THE OWNER OR THEIR REPRESENTATIVE SHALL NOTIFY THE CITY OF CELINA ENGINEERING DEPARTMENT AT 972-382-2682 x1081. CONSTRUCTION DRAWINGS STAMPED BY THE CITY OF CELINA SHALL BE ON THE PROJECT SITE AT ALL TIMES DURING CONSTRUCTION. THE CITY OF CELINA STANDARD SPECIFICATIONS FOR CONSTRUCTION SHALL TAKE PRECEDENCE OVER THESE PLANS WHENEVER IN CONFLICT THEREWITH. DISCLAIMER: ALL NECESSARY APPROVALS AND PERMITS SHALL BE ACQUIRED PRIOR TO CONSTRUCTION. EST. 1876



Trevor L. Castilla 8/24/15

No.	Bearing	Distance
L1	N88°37'54"W	44.44'
L2	N88°37'54"W	44.61'
L3	S88°37'54"E	44.56'
L4	S88°37'54"E	46.96'
L5	N88°37'54"W	44.44'

Curve No.	Radius	Arc Length	Delta	Chrd. Brg.	Chrd. Dist.
C1	30.50'	47.97'	90°06'47"	N46°18'42"E	43.18'
C2	54.50'	72.00'	75°41'47"	N53°31'12"E	66.88'
C3	30.50'	40.30'	75°41'47"	S53°31'12"W	37.43'
C4	30.50'	47.85'	89°53'13"	S43°41'18"E	43.09'
C5	30.50'	47.97'	90°06'47"	S46°18'43"W	43.18'
C6	30.50'	47.85'	89°53'13"	S43°41'18"E	43.09'
C7	30.50'	47.85'	89°53'13"	N43°41'17"W	43.09'
C8	54.50'	85.50'	89°53'13"	N43°41'17"W	77.00'
C9	30.50'	47.91'	90°00'00"	N43°37'54"W	43.13'
C10	56.50'	86.75'	90°00'00"	N43°37'54"W	79.90'
C11	30.50'	47.91'	90°00'00"	N46°22'06"E	43.13'
C12	54.50'	85.61'	90°00'00"	N46°22'06"E	77.07'

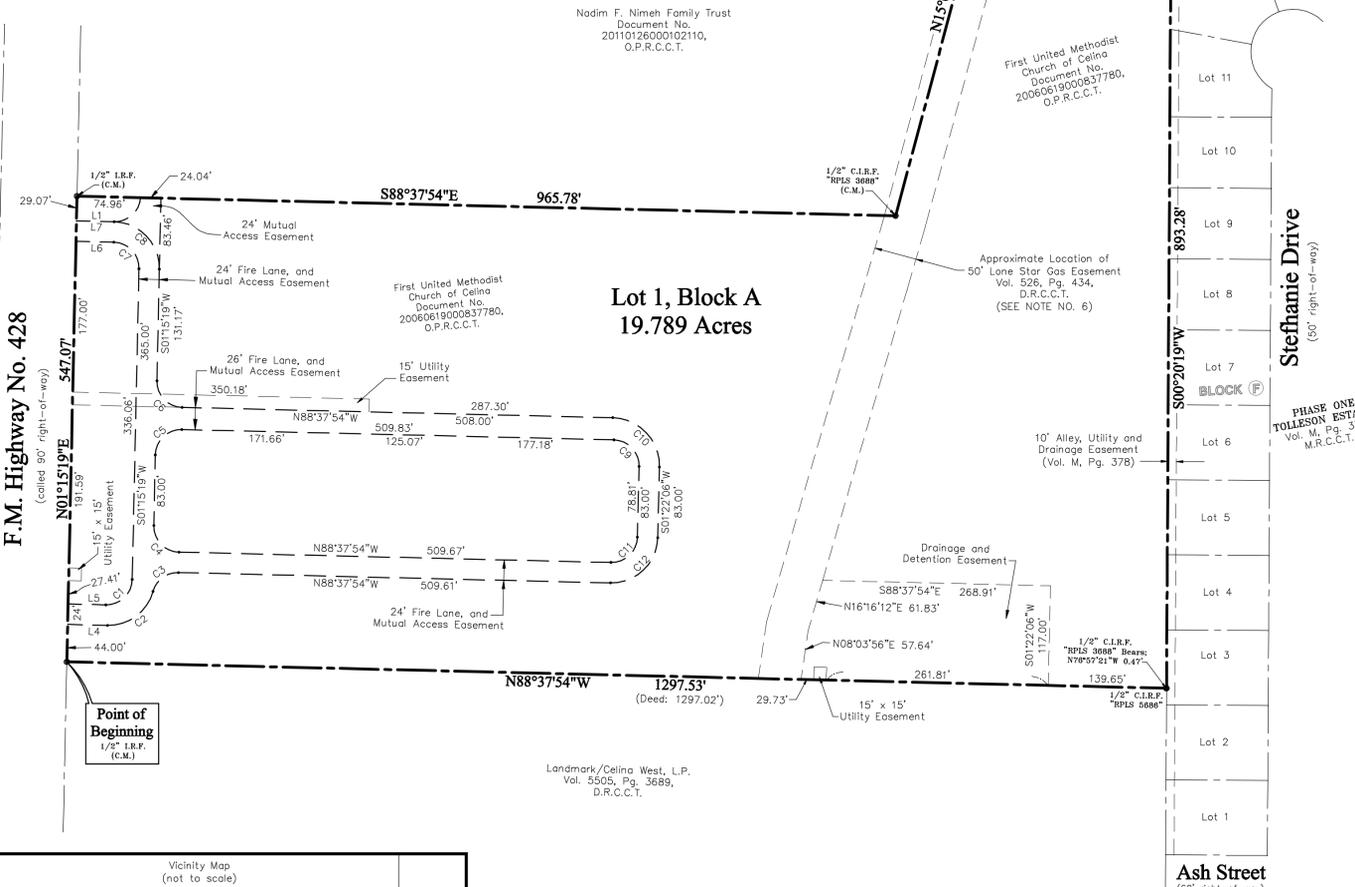

Nadim F. Nimeh Family Trust
Document No. 20110126000102110,
O.P.R.C.C.T.

First United Methodist Church of Celina
Document No. 20060619000837780,
O.P.R.C.C.T.

Lot 1, Block A
19.789 Acres

First United Methodist Church of Celina
Document No. 20060619000837780,
O.P.R.C.C.T.

Approximate Location of
Lone Star Gas Easement
Vol. 526, Pg. 434,
D.R.C.C.T.
(SEE NOTE NO. 6)

10' Alley, Utility and
Drainage Easement
(Vol. M, Pg. 378)


PHASE ONE
TOLLESON ESTATES
Vol. M, Pg. 378,
M.R.C.C.T.

Lot 25, Block A
PHASE TWO
TOLLESON ESTATES
Vol. O, Pg. 36,
M.R.C.C.T.

I.R.F. = Iron Rod Found
C.M. = Controlling Monument
M.R.C.C.T. = Map Records, Collin County, Texas
D.R.C.C.T. = Deed Records, Collin County, Texas
O.P.R.C.C.T. = Official Public Records, Collin County, Texas
C.I.R.F. = 1/2" Iron Rod With Cap Found

Notes:

- According to the Flood Insurance Rate Map of Collin County, Texas, Map No. 48085C0110J, Map Revised June 02, 2009, the herein described property is located in Zone "X", described by said map to be, "areas determined to be outside the 0.2% annual chance floodplain".
- Bearings are based on the westerly line of that tract of land described by deed to First United Methodist Church of Celina, as recorded under Document No. 20060619000837780, of the Official Public Records, Collin County, Texas.
- The purpose of this plat is to create one lot for future construction.
- Selling a portion of this addition by metes and bounds is a violation of city ordinance and state law, and is subject to withholding of utilities and building permits.
- The easement recorded in Volume 507, Page 370, of the Deed Records, Collin County, Texas, is a blanket style easement that affects the herein described property.
- The Gas Easement shown is described as being 18' west of the first pipeline installed, and as such, the exact location of said Gas Easement will need to be verified by the controlling authority.

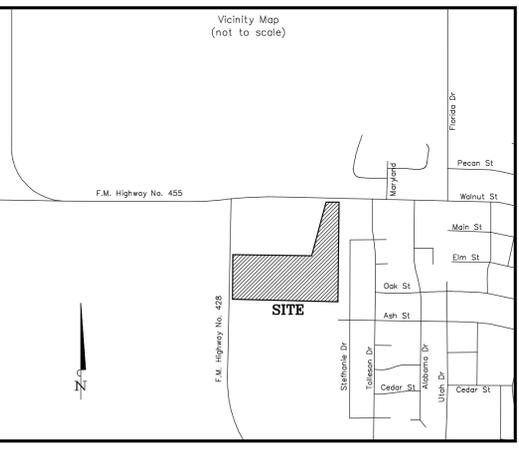

REVISED: 06/05/2015 FOR CITY COMMENTS				
REVISED: 04/23/2015 FOR CITY COMMENTS				
DATE: 03/24/2015	SCALE: 1" = 100'	DRAWN BY: C.S.H.	CHK'D BY: M.B.A.	JOB NO.: 2013-0175

F.M. Highway No. 455
(called 90' right-of-way)

Approved by the City of Celina for filing at the office of the County Clerk of Collin County, Texas.

"Recommended By" Planning and Zoning Commission
City of Celina, Texas

Signature of Chairperson _____ Date: _____

"Approved By" City Council
City of Celina, Texas

Signature of Mayor _____ Date: _____

"Attest" City Secretary _____ Date: _____

"Attest" City Secretary _____ Date: _____

This property is located within the Corporate Limits (or extraterritorial jurisdiction) of the City of Celina, Collin County, Texas.

Signature of Mayor _____ Date: _____

"Attest" City Secretary _____ Date: _____

SURVEYOR'S CERTIFICATE:

KNOW ALL MEN BY THESE PRESENTS:

THAT I, Michael B. Arthur, do hereby certify that I prepared this plat from an actual on-the-ground survey of the above described property, and that the corner monuments shown hereon were found or were properly placed under my personal supervision in accordance with the Platting Rules and Regulations of the City of Celina, Collin County, Texas.



Michael B. Arthur
Registered Professional Land Surveyor
Texas No. 5686

COUNTY OF COLLIN X
STATE OF TEXAS X


BEFORE ME, the undersigned, a Notary Public in and for the State of Texas, on this day personally appeared MICHAEL B. ARTHUR, known to me to be the person whose name is subscribed to the foregoing instrument, and acknowledged to me that he executed the same for the purposes and consideration therein expressed.

WITNESS MY HAND AND SEAL OF OFFICE on this, the _____ day of _____, 2015.

NOTARY PUBLIC in and for the State of Texas

Notes (continued):

- The undersigned does hereby covenant and agree that he or she or they shall construct upon the fire lane easements, as dedicated as shown hereon, a hard surface in accordance with the City of Celina's paving standards for fire lane, and that he or she or they shall maintain the same in a state of good repair at all times and keep the same free and clear of any structures, fences, trees, shrubs, or other improvements or obstruction, including but not limited to the parking of motor vehicles, trailers, boats or other impediments to the accessibility of fire apparatus. The maintenance of paving on the fire lane easements is the responsibility of the owner, and the owner shall post and maintain appropriate signs in conspicuous places along such fire lanes, stating "Fire Lane, No Parking." The local law enforcement agency(s) is hereby authorized to enforce parking regulations within the fire lanes, and to cause such fire lanes and utility easements to be maintained free and unobstructed at all times for Fire Department and emergency use.
- This plat is hereby adopted by the Owners and approved by the City of Celina (Called "City") subject to the following conditions which shall be binding upon the Owners, their heirs, grantees, successors and assigns: The portion of Lot 1, Block A, as shown on the plat is called "Drainage Easement," the Drainage Easement within the limits of this addition, will remain accessible at all times and will be maintained in a safe and sanitary condition by the owners of the lot or lots that are traversed by or adjacent to the Drainage Easement. The City will not be responsible for the maintenance and operation of said Easement or for any damage to private property or person that results from conditions in the Easement, or for the control of erosion. No construction of any type of building, fence or any other structure within the Drainage Easement, as herein above defined shall be permitted, unless approved by the City Engineer. Provided, however, it is understood that in the event it becomes necessary for the City to erect or consider erecting any type of drainage structure in order to improve the storm drainage that may be occasioned by drainage in or adjacent to the subdivision, then in such event, the city shall have the right to enter upon the Drainage Easement at any point, or points, to investigate, survey or to erect, construct and maintain any drainage facility deemed necessary for drainage purposes. Each property owner shall keep the Drainage Easement clean and free of debris, silt, and any substance which would result in unsanitary conditions or obstruct the flow of water, and the city shall have the right of ingress and egress for the purpose of inspection and supervision of maintenance work by the property owner to alleviate any undesirable conditions which may occur. The natural drainage through the Drainage Easement is subject to storm water overflow and natural bank erosion to an extent which cannot be definitely defined. The City shall not be held liable for any damages of any nature resulting from the failure of any structure or structures, within the easement.
- The undersigned does hereby covenant and agree that the access easement may be utilized by any person or the general public for ingress and egress to public vehicular and pedestrian use and access, and for Fire Department and emergency use in, along, upon and across said premises, with the right and privilege at all times of the City of Celina, its agents, employees, workmen and representatives having ingress, egress, and regress in, along, upon and across said premises.

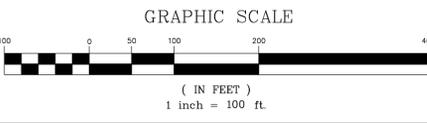

OWNER:
First United Methodist Church of Celina

ENGINEER:
Trevor L. Castilla, P.E.
Civil Consulting Group, PLLC
Texas Firm No. F-9856
1515 Heritage Drive, Suite 212 | McKinney, Texas | 75069 | 972.569.9199
102 N. Shiloh Road, Suite 204 | Garland, Texas | 75042 | 972.487.8380
972.569.9197 (fax)

SURVEYOR:
North Texas Surveying, L.L.C.
Registered Professional Land Surveyors
1515 South McDonald St. Suite 110
McKinney, Tx. 75069
Ph. (469) 424-2074 Fax: (469) 424-1997
www.northtexasurveying.com

OWNER'S CERTIFICATE

COUNTY OF COLLIN X
STATE OF TEXAS X

WHEREAS, FIRST UNITED METHODIST CHURCH OF CELINA is the owner of a tract of a land situated in the M.E.P. and P.R.R. Survey, Abstract No. 644, in the City of Celina, Collin County, Texas, said being described by deed to First United Methodist Church of Celina (FUMC), as recorded under Document No. 20060619000837780, of the Official Public Records, Collin County, Texas (O.P.R.C.C.T.), said tract being more particularly described as follows:

- BEGINNING** at a 1/2" iron rod found at the southwesterly corner of said FUMC tract, same being the northwesterly corner of a tract of land described by deed to Landmark/Celina West, L.P., as recorded in Volume 5505, Page 3689, of the Deed Record, of Collin County, Texas (D.R.C.C.T.), same being in the easterly monumented line of F.M. Highway No. 428;
- THENCE** North 01°15'19" East, along the easterly monumented line of said F.M. Highway No. 428, a distance of 547.07' to a 1/2" iron rod found at the most westerly northwest corner of said FUMC tract, same being the southwesterly corner of a tract of land described by deed to Nadim F. Nimeh Family Trust, as recorded under Document No. 20110126000102110, O.P.R.C.C.T.;
- THENCE** South 88°37'54" East, along the common line between said Nimeh and FUMC tracts, a distance of 965.78' to a 1/2" iron rod with a plastic cap stamped "RPLS 3688" found for the southeasterly corner of said Nimeh tract, same being an angle point of said FUMC tract;
- THENCE** North 15°06'00" East, continuing along the common line between said Nimeh and FUMC tracts, a distance of 669.13' to a 1/2" iron rod found for the northeasterly corner of said Nimeh tract, same being the most northerly northwest corner of said FUMC tract, said corner also being in the southerly monumented line of F.M. Highway No. 455;
- THENCE** South 88°39'54" East, along the southerly monumented line of F.M. Highway No. 455, a distance of 152.64' to a point for corner from which a 3/8" iron rod found bears, South 73°49'35" East, a distance of 1.20' and a 1/2" iron rod found bears, South 00°23'18" West, a distance of 3.97', said point for corner being the northeasterly corner of said FUMC tract, same also being the northwesterly corner of that tract of land described by deed to SPJ Holdings, LLC, as recorded under Document No. 20070503000600710, O.P.R.C.C.T.;
- THENCE** South 00°22'02" West, along the common line between said SPJ Holdings, LLC and FUMC tracts, a distance of 304.07' to a 1/2" iron rod found at the southwesterly corner of said SPJ Holdings, LLC tract, same being the northwesterly corner of Lot 12, Block F, of **PHASE ONE TOLLESON ESTATES**, an addition to the City of Celina, as recorded in Volume M, Page 378, of the Map Records, of Collin County, Texas (M.R.C.C.T.);
- THENCE** South 00°20'19" West, along the common line between said **PHASE ONE TOLLESON ESTATES** and FUMC tract, a distance of 893.28' to a 1/2" iron rod with a yellow plastic cap stamped "RPLS 5686" set at the southeasterly corner of said FUMC tract, said corner also being the northeasterly corner of the aforementioned Landmark/Celina West, L.P. tract, from which a 1/2" iron rod with a plastic cap stamped "RPLS 3688" bears, North 76°57'21" West, a distance of 0.47';
- THENCE** North 88°37'54" West, along the common line between said FUMC and Landmark/Celina West, L.P. tracts, a distance of 1297.53' to the **POINT OF BEGINNING** and containing 19.789 acres of land, more or less.

COUNTY OF COLLIN X
STATE OF TEXAS X

NOW, THEREFORE, KNOW ALL MEN BY THESE PRESENTS:

That we, FIRST UNITED METHODIST CHURCH OF CELINA, do hereby adopt this plat designating the herein above described property as **FIRST UNITED METHODIST CHURCH OF CELINA ADDITION**, an addition to the City of Celina, Collin County, Texas and do hereby dedicate in fee simple, to the public use forever, the streets, rights-of-way, and other public improvements shown hereon. The easements shown thereon are hereby reserved for the purposes indicated. No buildings, fences, trees, shrubs or other improvements or growths shall be constructed, reconstructed or placed upon, over or across the easements as shown. Said easements being hereby reserved for mutual use and accommodation of all public utilities using or desiring to use the same unless the easement limits the use to particular utilities, said use by public utilities being subordinate to the public's and City of Celina's use thereof. The City of Celina and public utility entities shall have the right to remove and keep removed all or part of any buildings, fences, trees, shrubs or other improvements or growths which in any way may endanger or interfere with the construction, maintenance or efficiency of its respective system on the easements, and all public utilities shall at all times have full right of ingress and egress to or from and upon the said easements for the purpose of constructing, reconstructing, inspecting, patrolling, maintaining and adding to or removing all or parts of its respective systems without the necessity at any time of procuring the permission of anyone. (Any public utility shall have the right of ingress and egress to private property for the purpose of reading meters and any maintenance or service required or ordinarily performed by the utility).

This plat is approved subject to all platting ordinances, rules, regulations and resolutions of the City of Celina, Texas.

Witness my hand, this the _____ day of _____, 2015.

By: _____
Authorized Representative

COUNTY OF COLLIN X
STATE OF TEXAS X

BEFORE ME, the undersigned, a Notary Public in and for the State of Texas, on this day personally appeared _____, known to me to be the person whose name is subscribed to the foregoing instrument and acknowledged to me that the same is his act and deed in the capacity therein stated and for the purposes therein expressed.

WITNESS MY HAND AND SEAL OF OFFICE on this, the _____ day of _____, 2015.

NOTARY PUBLIC in and for the State of Texas

CONSTRUCTION PLAT
FIRST UNITED METHODIST CHURCH OF CELINA
Lot 1, Block A

862,018 / 19.789 Acres
M.E.P. and P.R.R. Survey,
Abstract No. 644
City of Celina, Collin County, Texas

GENERAL

1. All construction shall be in accordance with the latest revision of the North Central Texas Council of Governments "Standard Specifications for Public Works Construction" including the Standard Drawings therein and the City of Celina's addendum thereto. Contractor shall have at least one set of approved Engineering Plans and Specifications on-site at all times.
2. Before beginning construction, the contractor shall prepare a construction sequence schedule. The construction schedule shall be such that there is minimum interference with traffic along or adjacent to the project.
3. Construction may not begin earlier than 7:00 A.M. on weekdays nor continue after dark without permission from the City of Celina. Construction on holidays and Saturday must be approved two days in advance. A fee of \$300.00 a day for working on holidays and Saturday will be assessed payable to the city before work is performed. Work may not begin before 8:00 A.M. on holidays and Saturday and work on Sunday is prohibited without special permission and payment of fees.
4. Utilities shown on the plans were taken from field surveys and information provided by the utility companies. The completeness and the accuracy of this data is not guaranteed.

The contractor is responsible for verifying the location of all underground utilities and structures and protecting them from damage during construction.

It will be the responsibility of each contractor to protect all existing public and private utilities throughout the construction of this project. Contractor shall contact the appropriate utility companies for line location prior to commencement of construction and shall assume full liability to those companies for any damages caused to their facilities.

DIG TESS	800-DIG-TESS
GCEC-TELECOM	903-482-7274
GCEC-ELECTRIC	903-821-3007
AT&T	972-569-3013
ATMOS ENERGY	972-841-4161
ATMOS ENERGY	214-341-9900
CROSSTEX ENERGY	817-570-6753
ONEOK	903-257-6594
COSERV-ELEC	940-321-7800
COSERV-GAS	940-321-7800
CITY OF CELINA	972-382-2682
TOWN OF PROSPER	972-347-9969
MARILEE SUD	972-382-3222
GRANDE	972-410-0583
SUDDEN LINK	469-853-0486

5. Work may not be backfilled or covered until the City has inspected it.
6. Material testing shall be performed by an independent testing laboratory and paid for by the Contractor. The following material tests shall be provided by the Contractor:
 - a. Embankment - One soil density test shall be performed at each location for each 500 C.Y. of backfill placed.
 - b. Pavement Sub grade - One gradation test (where lime stabilized) and one soil density test shall be performed for each 300 linear feet of pavement unless otherwise noted. Gradations must pass 100% through a 1 3/4" sieve and 60% through a #4 sieve.
 - c. Utility Trench Backfill - One soil density test shall be performed at 300 feet intervals or as directed by the Inspector.
 - d. Concrete Tests:
 - (1). Compressive Strength - Four test cylinders shall be taken from a representative portion of the concrete being placed for every 150-cubic yards of concrete pavement placed, but in no case shall less than 2 sets of cylinders be taken from any one day's placement.)
 - (2). Air, slump, and temperature tests shall be taken for every set of cylinders made. Concrete with a temperature above 95° F will be rejected.
 - (3). Additional cylinders and/or tests may be required at the Inspector's discretion.

The City shall select the location and depth of each soil density test unless otherwise directed.
7. All excavation on the project is unclassified.
8. Temporary erosion control shall be used to minimize the spread of silt and mud from the project on to existing streets, alleys, drainage ways and public and private property. Temporary erosion controls may include silt fences, rock check dams, stabilized construction entrances, straw bales, berms, dikes, swales, strips of undisturbed vegetation, check dams and other methods as required by the City Manager or his representative and shall conform to the Storm Water Quality Best Management Practices for Construction Activities as published by the North Central Texas Council of Governments and the City of Celina Erosion and Sediment Control Manual.
9. Finished slopes on public rights-of-way and easements shall not be steeper than 4:1. All slopes steeper than 6:1 shall be covered with erosion control matting and are hydro mulched and maintained by the contractor until grass covers all parts of the slope.
10. The contractor shall maintain two-way traffic at all times along the project.
11. Remove, salvage and replace all street and traffic control signs, which may be damaged by the construction of the project.
12. All trenching and excavation shall be performed in accordance with OSHA standards. Trench safety design will be the responsibility of the Contractor. Contractor shall submit a trench safety design approved by a professional engineer to the City for review prior to the start of any underground utility construction.

PAVING

1. All embankments shall be compacted to 95% Standard Proctor density.
2. All streets and alleys shall be placed on lime stabilized subgrade with a lime content of not less than 7 1/2% or as approved by city engineer.
3. The minimum 28 day compressive strength of concrete street paving shall not be less than 3600 psi and shall be air entrained. Water may not be applied to the surface of concrete paving to improve workability.
4. All curb and gutter shall be integral with the pavement.
5. Parabolic crowns are required on all street pavements except on major thoroughfares where straight sections are required.
6. Streets and alleys shall be constructed with provisions for sidewalk ramps at all intersections.

DRAINAGE

1. Storm sewer pipe shall be reinforced concrete, Class III unless otherwise noted.
2. All structural concrete shall be Class "C" (3600 psi compressive strength at 28 days), air entrained.
3. The contractor shall install plugs in storm sewer lines or otherwise prevent mud from entering the storm sewer system during construction.

WATER AND SANITARY SEWER

1. Water mains shall be AWWA C-900 or 905 PVC Class 200 unless otherwise noted. Minimum cover for waterlines is 48" below top of curb, 60" where no curbed street is present or as required to clear existing utilities, whichever is greater. Class B+ embedment unless otherwise noted.
2. All utility trench backfill shall be performed in 12" loose lifts and mechanically compacted with approved vibratory methods.
3. Marking tape shall be installed one foot above and over PVC water lines.
4. Fittings for PVC water lines shall be ductile iron and be encased in a polyethylene sheath.
5. All Mechanical Joints will be restrained. (Mega-Lug etc.)
6. Valves, including tapping valves shall be resilient seat gate valves, unless noted otherwise.
7. All direct burial valves shall be provided with cast iron valve boxes with PVC stacks. Valve stacks shall be vertical and concentric with the valve stem. Stainless steel valve extensions are required on all valves where the operating nut is greater than 4 feet below finished grade.
8. Fire hydrants shall be Kennedy or equal as directed or approved by the City of Celina on a case by case basis and field painted silver with bonnet and caps color-coded to pipe size.
 - a. Six inch line- silver body with RED bonnet and caps.
 - b. Eight inch line- silver body with BLUE bonnet and caps.
 - c. Ten inch line- silver body with GREEN bonnet and caps.
 - d. Twelve inch and larger- silver body with YELLOW bonnet and caps.
9. All exposed bolting on any buried equipment or material shall be stainless steel. Included are:
 - a. Bonnet and stuffing box bolts on valves.
 - b. Shoe bolts on fire hydrants.
 - c. Flange bolts.
 - d. "Cor-ten" mechanical joint "T" bolts are acceptable for direct burial service.
10. Depending on meter size; meter boxes shall be DFW37C-12-1SAF, DFW38C-14-1SAF, DFW65C-14-1SAF, or approved equal, and shall incorporate the Celina logo in the lid.
11. One sample station shall be provided to the city for every 250 connections.
12. Sanitary sewer mains shall be DR 35 PVC. Embedment shall be Class H unless otherwise noted.
 - a. The contractor shall install and maintain watertight plugs in all connections to the City's sanitary sewer system until the City accepts the project.
 - b. All sanitary sewer lines and manholes shall be leak tested before the project is accepted. Deflection testing of PVC sewer lines is required. Deflection shall be tested with a mandrel for 5% deflection.
 - c. All sewer lines shall be video inspected with a copy of the video and station report submitted to the Inspector.
 - d. Mandrel, Air Test, and Video inspection shall not be performed until all utilities are complete, in place, and backfilled.

Specifications are not meant to exclude any other manufacturer. Any specification may be replaced with an approved equal upon approval by the City of Celina.


NO.	REVISION	BY	DATE

**FIRST UNITED METHODIST CHURCH - CELINA
LOT 1, BLOCK A
FIRST UNITED METHODIST CHURCH ADDITION
CITY OF CELINA, COLLIN COUNTY, TEXAS**

GENERAL NOTES

DESIGNED- TLC	DRAWN- JRK	DATE- 8/24/2015	C-1
APPROVED- CCG	CHECKED- TLC	SCALE-	

FILENAME: FLUMC*NOTES.dgn
PLOTTED: 8/24/2015

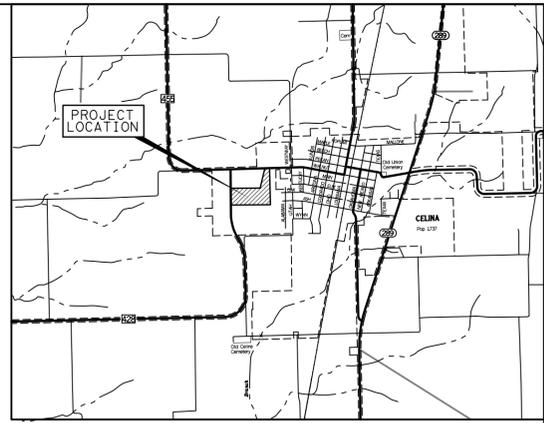

LOCATION MAP

LEGEND

- 5" REINF. CONCRETE PAVEMENT (3600 PSI)(#3 @ 24" O.C.E.W.)
- 6" REINF. CONCRETE PAVEMENT (3600 PSI)(#3 @ 24" O.C.E.W.)
- EXIST. ASPHALTIC PAVEMENT
- PROPOSED FIRELANE

DRIVEWAY CONNECTION DETAIL

SECTION A-A

NADIM F. NIMEH FAMILY TRUST
DOCUMENT NO. 2011012600010211,
O.P.R.C.C.T.

SITE PLAN DATA


LOT SIZE: 19.789 AC
ZONING: SF 7.5
LAND USE: CHURCH
SANCTUARY SEATS: 240 SEATS (PHASE 1)
PARKING REQUIREMENTS: 1 SPACE / 3 SANCTUARY SEATS (80 SPACES)
FRONT YARD LANDSCAPING: 15' FRONT YARD LANDSCAPE SETBACK
PERIMETER LANDSCAPING: 5' BUFFER CONTAINING A WALL, FENCE, HEDGE OR BERM
FRONT YARD: 25'
SIDE YARD: 8'
REAR YARD: 25'

BUILDING AREA


SANCTUARY: 5,120 SF
EDUCATION & OFFICES: 11,704 SF
TOTAL BUILDING AREA: 16,824 SF
MAX BUILDING HEIGHT: 76'-5"

PARKING SUMMARY

PHASE 1 - 81 SPACES (4 HC)
TOTAL 81 SPACES (4 HC)

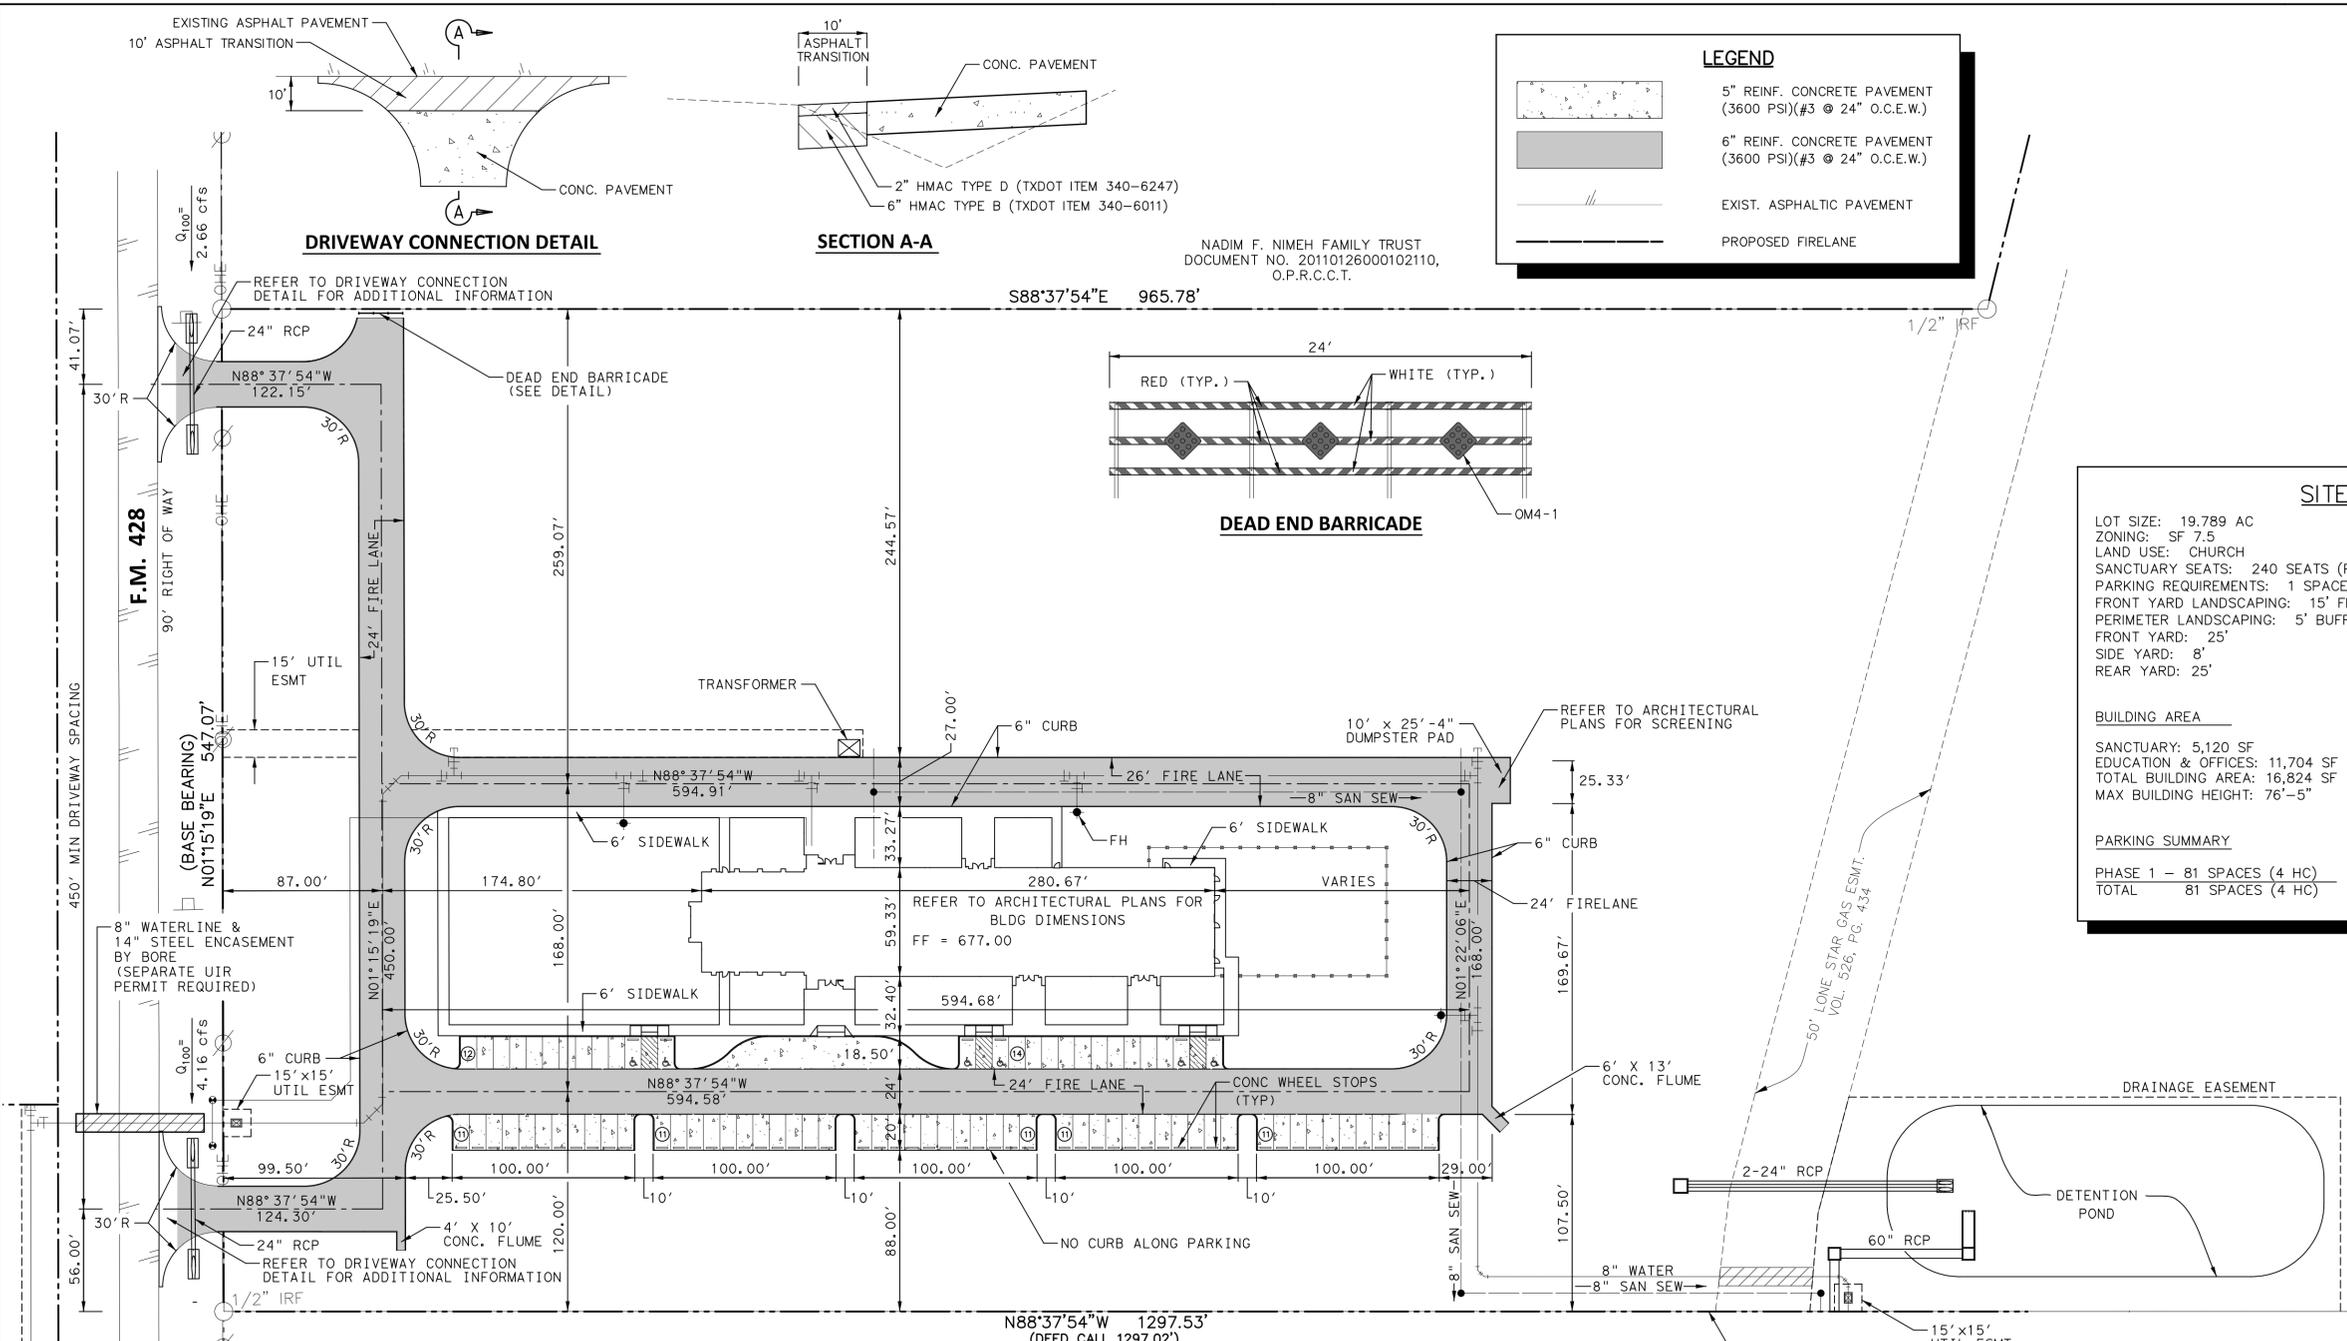

DEAD END BARRICADE

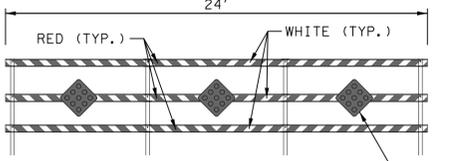

NOTES

- ALL DIMENSIONS ARE TO BACK OF CURB, UNLESS NOTED OTHERWISE.
- ALL DRIVEWAYS SHALL BE BUILT IN ACCORDANCE TO THE CITY OF CELINA DETAILS.
- NO LANDSCAPING SUCH AS TREES, HEDGES, ABOVE AND UNDERGROUND STRUCTURES SHALL BE LOCATED WITHIN EXISTING OR PROPOSED UTILITY EASEMENTS AND RIGHT OF WAY.
- REFER TO ARCHITECTURAL PLANS FOR BUILDING DIMENSIONS.
- FIRE LANES SHALL BE A MINIMUM OF 6" CONCRETE REINFORCED WITH #3 BARS @ 24" O.C.E.W. COMPRESSIVE STRENGTH SHALL BE A MINIMUM OF 3600 PSI.
- FIRE LANES SHALL BE MARKED BY PAINTED LINES OF RED TRAFFIC PAINT 6" WIDE TO SHOW THE EXACT BOUNDARY LINES OF THE FIRE LANE. THE LINES SHALL BE MARKED BY PAINTED 4-INCH HIGH LETTERING, USING A 1-INCH WIDE STROKE OF WHITE TRAFFIC PAINT ON THE CONTRASTING RED BACKGROUND STATING: "NO PARKING - FIRE LANE" OR "FIRE LANE NO PARKING". THIS MARKING IS TO BE PLACED AT 25-FOOT INTERVALS ALONG EACH BOUNDARY LINE. WHERE A CURB IS AVAILABLE, THE STRIPING SHALL BE ON THE VERTICAL FACE OF THE CURB.
- ALL PARKING STALLS ARE 9' X 18' UNLESS NOTED OTHERWISE.
- CURB RADII ARE 3' UNLESS NOTED OTHERWISE.
- DUMPSTER AND STORAGE PADS SHALL BE A MINIMUM OF 8" CONCRETE REINFORCED WITH #3 BARS @ 24" O.C.E.W. COMPRESSIVE STRENGTH SHALL BE A MINIMUM OF 4000 PSI.
- ALL STANDARD PARKING STALLS SHALL BE WHITE TRAFFIC PAINT (4") IN ACCORDANCE TO THE TXMUTCD AND TEXAS ACCESSIBILITY STANDARDS.
- THE UPPER 6" OF THE SUBGRADE UNDER THE PROPOSED PAVEMENT SHALL CONSIST OF COMPACTED SOILS WITH PI OF LESS THAN 15% OR COMPACTED/STABILIZED BY ADDING 6% (BY DRY WEIGHT) OF HYDRATED LIME. ALTERNATIVELY, THE THICKNESS OF THE HEAVY DUTY PAVEMENT CAN BE INCREASED BY 2" IN-LIEU OF STABILIZING THE UPPER 6" OF SOILS UNDER THE PAVEMENT.
- THE CONTRACTOR SHALL REVIEW AND ADHERE TO THE GEOTECHNICAL REPORT PREPARED BY REED ENGINEERING GROUP DATED NOVEMBER 18, 2013.


CASE NAME:
CASE NUMBER:
LOCATION:

DIRECTOR OF DEVELOPMENT SERVICES
DATE: _____
APPROVAL DOES NOT AUTHORIZE ANY WORK IN CONFLICT WITH ANY CODES OR ORDINANCES.
CITY OF CELINA
DEPARTMENT OF DEVELOPMENT SERVICES

FIRST UNITED METHODIST CHURCH OF CELINA
LOT 1, BLOCK A
862,018 / 19,789 AC.
M.E.P. AND P.R.R. SURVEY
ABSTRACT NO. 644
CITY OF CELINA,
COLLIN COUNTY, TEXAS

OWNER: FIRST UNITED METHODIST CHURCH
112 COLORADO STREET
CELINA, TEXAS 75069
972.382.2655

APPLICANT/ENGINEER: CIVIL CONSULTING GROUP
1515 HERITAGE DRIVE, SUITE 212
MCKINNEY, TEXAS 75069
972.569.9193

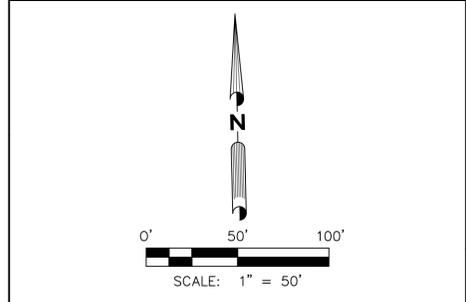

STATE OF TEXAS
TREVOR L. CASTILLA
85405
PROFESSIONAL ENGINEER
Trevor L. Castilla 8/24/15


NO.	REVISION	BY	DATE

FIRST UNITED METHODIST CHURCH - CELINA
LOT 1, BLOCK A
FIRST UNITED METHODIST CHURCH ADDITION
CITY OF CELINA, COLLIN COUNTY, TEXAS

PHASE 1 SITE PLAN

DESIGNED- TLC	DRAWN- JRK	DATE- 8/24/2015	C-2
APPROVED- CCG	CHECKED- TLC	SCALE-	

FILENAME: FLMC*SITEPLAN.dgn
PLOTTED: 8/24/2015

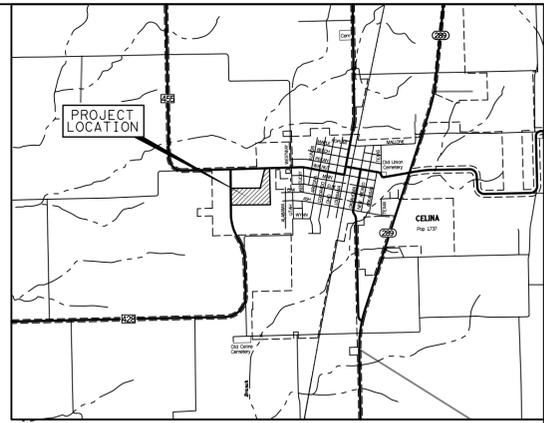

LOCATION MAP

SITE PLAN DATA


LOT SIZE: 19.789 AC
 ZONING: SF 7.5
 LAND USE: CHURCH
 SANCTUARY SEATS: 240 SEATS (PHASE 1)
 PARKING REQUIREMENTS: 1 SPACE / 3 SANCTUARY SEATS (80 SPACES)
 FRONT YARD LANDSCAPING: 15' FRONT YARD LANDSCAPE SETBACK
 PERIMETER LANDSCAPING: 5' BUFFER CONTAINING A WALL, FENCE, HEDGE OR BERM
 FRONT YARD: 25'
 SIDE YARD: 8'
 REAR YARD: 25'

BUILDING AREA

SANCTUARY: 5,120 SF
 EDUCATION & OFFICES: 11,704 SF
 TOTAL BUILDING AREA: 16,824 SF
 MAX BUILDING HEIGHT: 76'-5"

PARKING SUMMARY

PHASE 1 - 81 SPACES (4 HC)
 TOTAL 81 SPACES (4 HC)

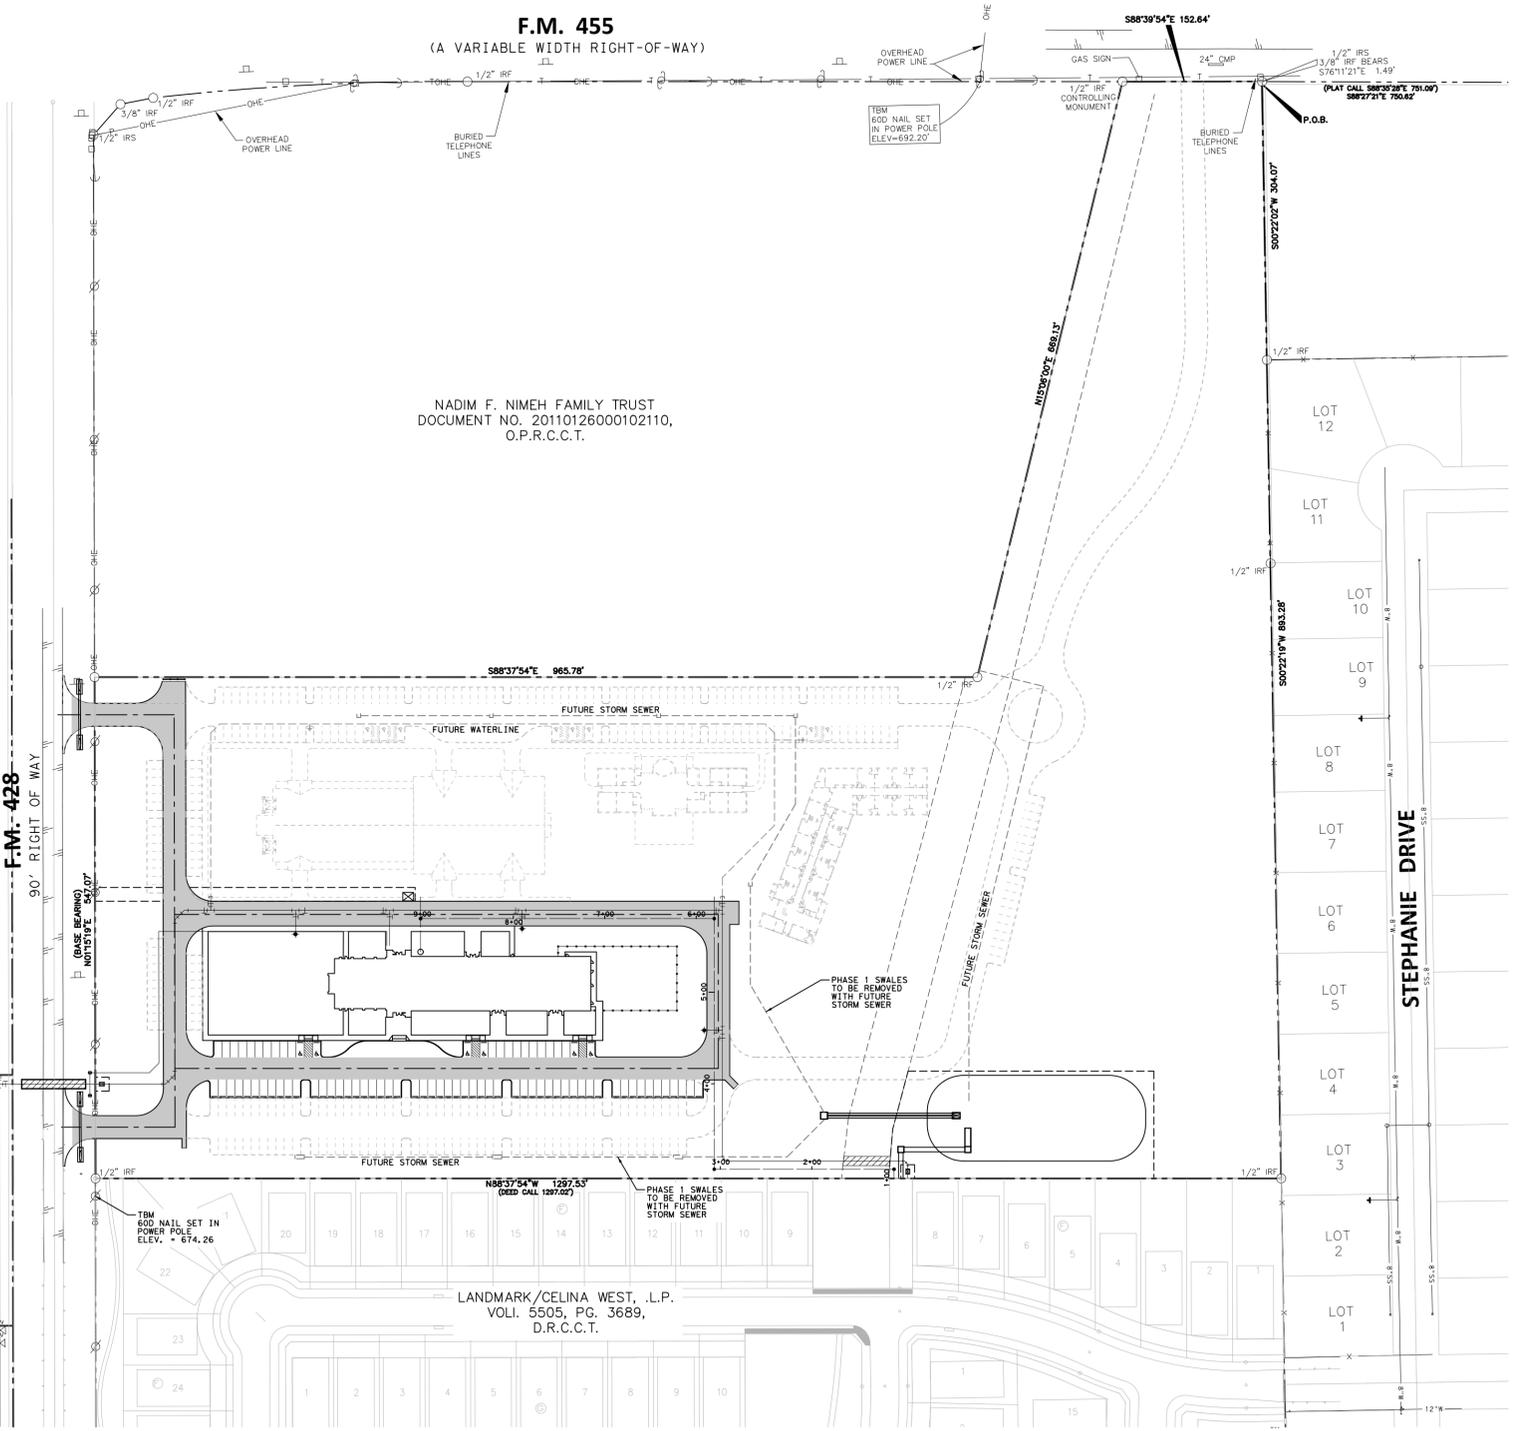


NADIM F. NIMEH FAMILY TRUST
 DOCUMENT NO. 20110126000102110,
 O.P.R.C.C.T.

LANDMARK/CELINA WEST, L.P.
 VOL. 5505, PG. 3689,
 D.R.C.C.T.

BADI SARMAD & SAMIEH BADI GARZA
 ABS A0124 HENRY BENTLEY SURVEY,
 TRACT 10

Stephen Harold Mills
 Vol. 4967, Pg. 3011 DRCCCT
 Zoned SF-7.5

Lot 1, Block 1
 CELINA CITY PARK ADDITION
 Cab. 2013, Pg. 100 PRCCCT Zoned AG

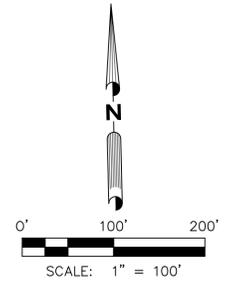

STATE OF TEXAS
 TREVOR L. CASTILLA
 85405
 LICENSED PROFESSIONAL ENGINEER
Trevor L. Castilla 8/24/15

NO.	REVISION	BY	DATE

CIVIL CONSULTING GROUP
 1515 HERITAGE DRIVE, STE. 212
 MCKINNEY, TEXAS 75069
 P 972.569.9193 F 972.569.9197
 TEXAS REGISTERED ENGINEERING FIRM NO. F-9356

**FIRST UNITED METHODIST CHURCH - CELINA
 LOT 1, BLOCK A
 FIRST UNITED METHODIST CHURCH ADDITION
 CITY OF CELINA, COLLIN COUNTY, TEXAS**

**OVERALL
 CONCEPTUAL SITE PLAN**

DESIGNED- TLC	DRAWN- JRK	DATE- 8/24/2015
APPROVED- CCG	CHECKED- TLC	SCALE-

C-3



OWNER
 FIRST UNITED METHODIST CHURCH
 112 COLORADO STREET
 CELINA, TEXAS 75069
 972.382.2655

APPLICANT/ENGINEER
 CIVIL CONSULTING GROUP
 1515 HERITAGE DRIVE, SUITE 212
 MCKINNEY, TEXAS 75069
 972.569.9193


F.M. 428

NADIM F. NIMEH FAMILY TRUST
DOCUMENT NO. 20110126000102110,
O.P.R.C.C.T.

- ### GRADING NOTES
1. THE CONTRACTOR SHALL REVIEW AND ADHERE TO THE GEOTECHNICAL REPORT PREPARED BY REED ENGINEERING GROUP DATED NOVEMBER 18, 2013.
 2. ALL VEGETATION AND TOPSOIL CONTAINING ORGANIC MATERIAL SHOULD BE CLEARED AND GRUBBED AT THE BEGINNING OF EARTHWORK CONSTRUCTION. AREAS OF SITE THAT WILL UNDERLIE FILL OR WITHIN THE BUILDING SHOULD BE SCARIFIED TO A DEPTH OF SIX INCHES (6") AND RECOMPACTED TO A MINIMUM OF 92% AND A MAXIMUM OF 98% OF THE MAXIMUM DENSITY, AS DETERMINED BY ASTM D-698, "STANDARD PROCTOR".
 3. THE MOISTURE CONTENT SHOULD RANGE FROM +1% TO +4% ABOVE OPTIMUM.
 4. SITE EXCAVATED SOILS SHOULD BE PLACED IN MAXIMUM 8" LOOSE LIFTS AND COMPACTED TO THE MOISTURE AND DENSITY REQUIREMENTS OUTLINED ABOVE. THE SOILS SHOULD BE UNIFORMLY BLENDED WITH WATER TO ACHIEVE THE REQUIRED MOISTURE CONTENT.
 5. IT IS RECOMMENDED THAT A TESTING AGENCY PERFORM ONE-POINT SWELL TESTS AT A PRESSURE OF 450 PSF ON LABORATORY SAMPLES COMPACTED TO THE ABOVE RECOMMENDED DENSITY AND MOISTURE. IF TEST RESULTS INDICATE THAT THE SWELL WILL EXCEED ONE PERCENT, THE FIELD MOISTURE SHOULD BE ADJUSTED TO LIMIT THE POTENTIAL FOR SWELL TO LESS THAN ONE PERCENT.
 6. PROPER BACKFILL AROUND THE BUILDING PERIMETER WILL REDUCE THE POTENTIAL FOR WATER SEEPAGE BENEATH THE STRUCTURES. FILL AGAINST THE PERIMETER OF THE FOUNDATIONS SHOULD CONSIST OF SITE EXCAVATED CLAYS, OR EQUAL, PLACED AND COMPACTED IN ACCORDANCE WITH THE RECOMMENDATIONS OUTLINED ABOVE.
 7. ALL ADA ACCESSIBLE PARKING STALLS SHALL BE A MAX 2% GRADE IN ALL DIRECTIONS. THE CONTRACTOR SHALL VERIFY GRADES AND NOTIFY ENGINEER OF ANY GRADES EXCEEDING 2% PRIOR TO PLACING CONCRETE.
 8. SIDEWALK CROSS SLOPE SHALL BE 1.5% DESIREABLE, 2% MAXIMUM.

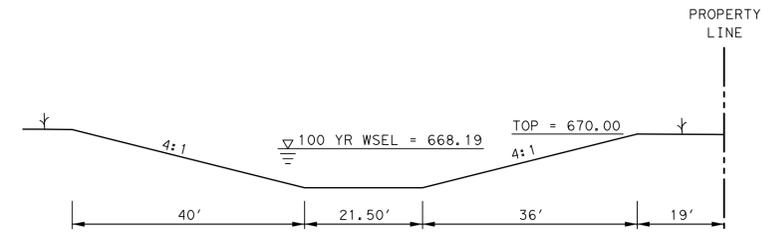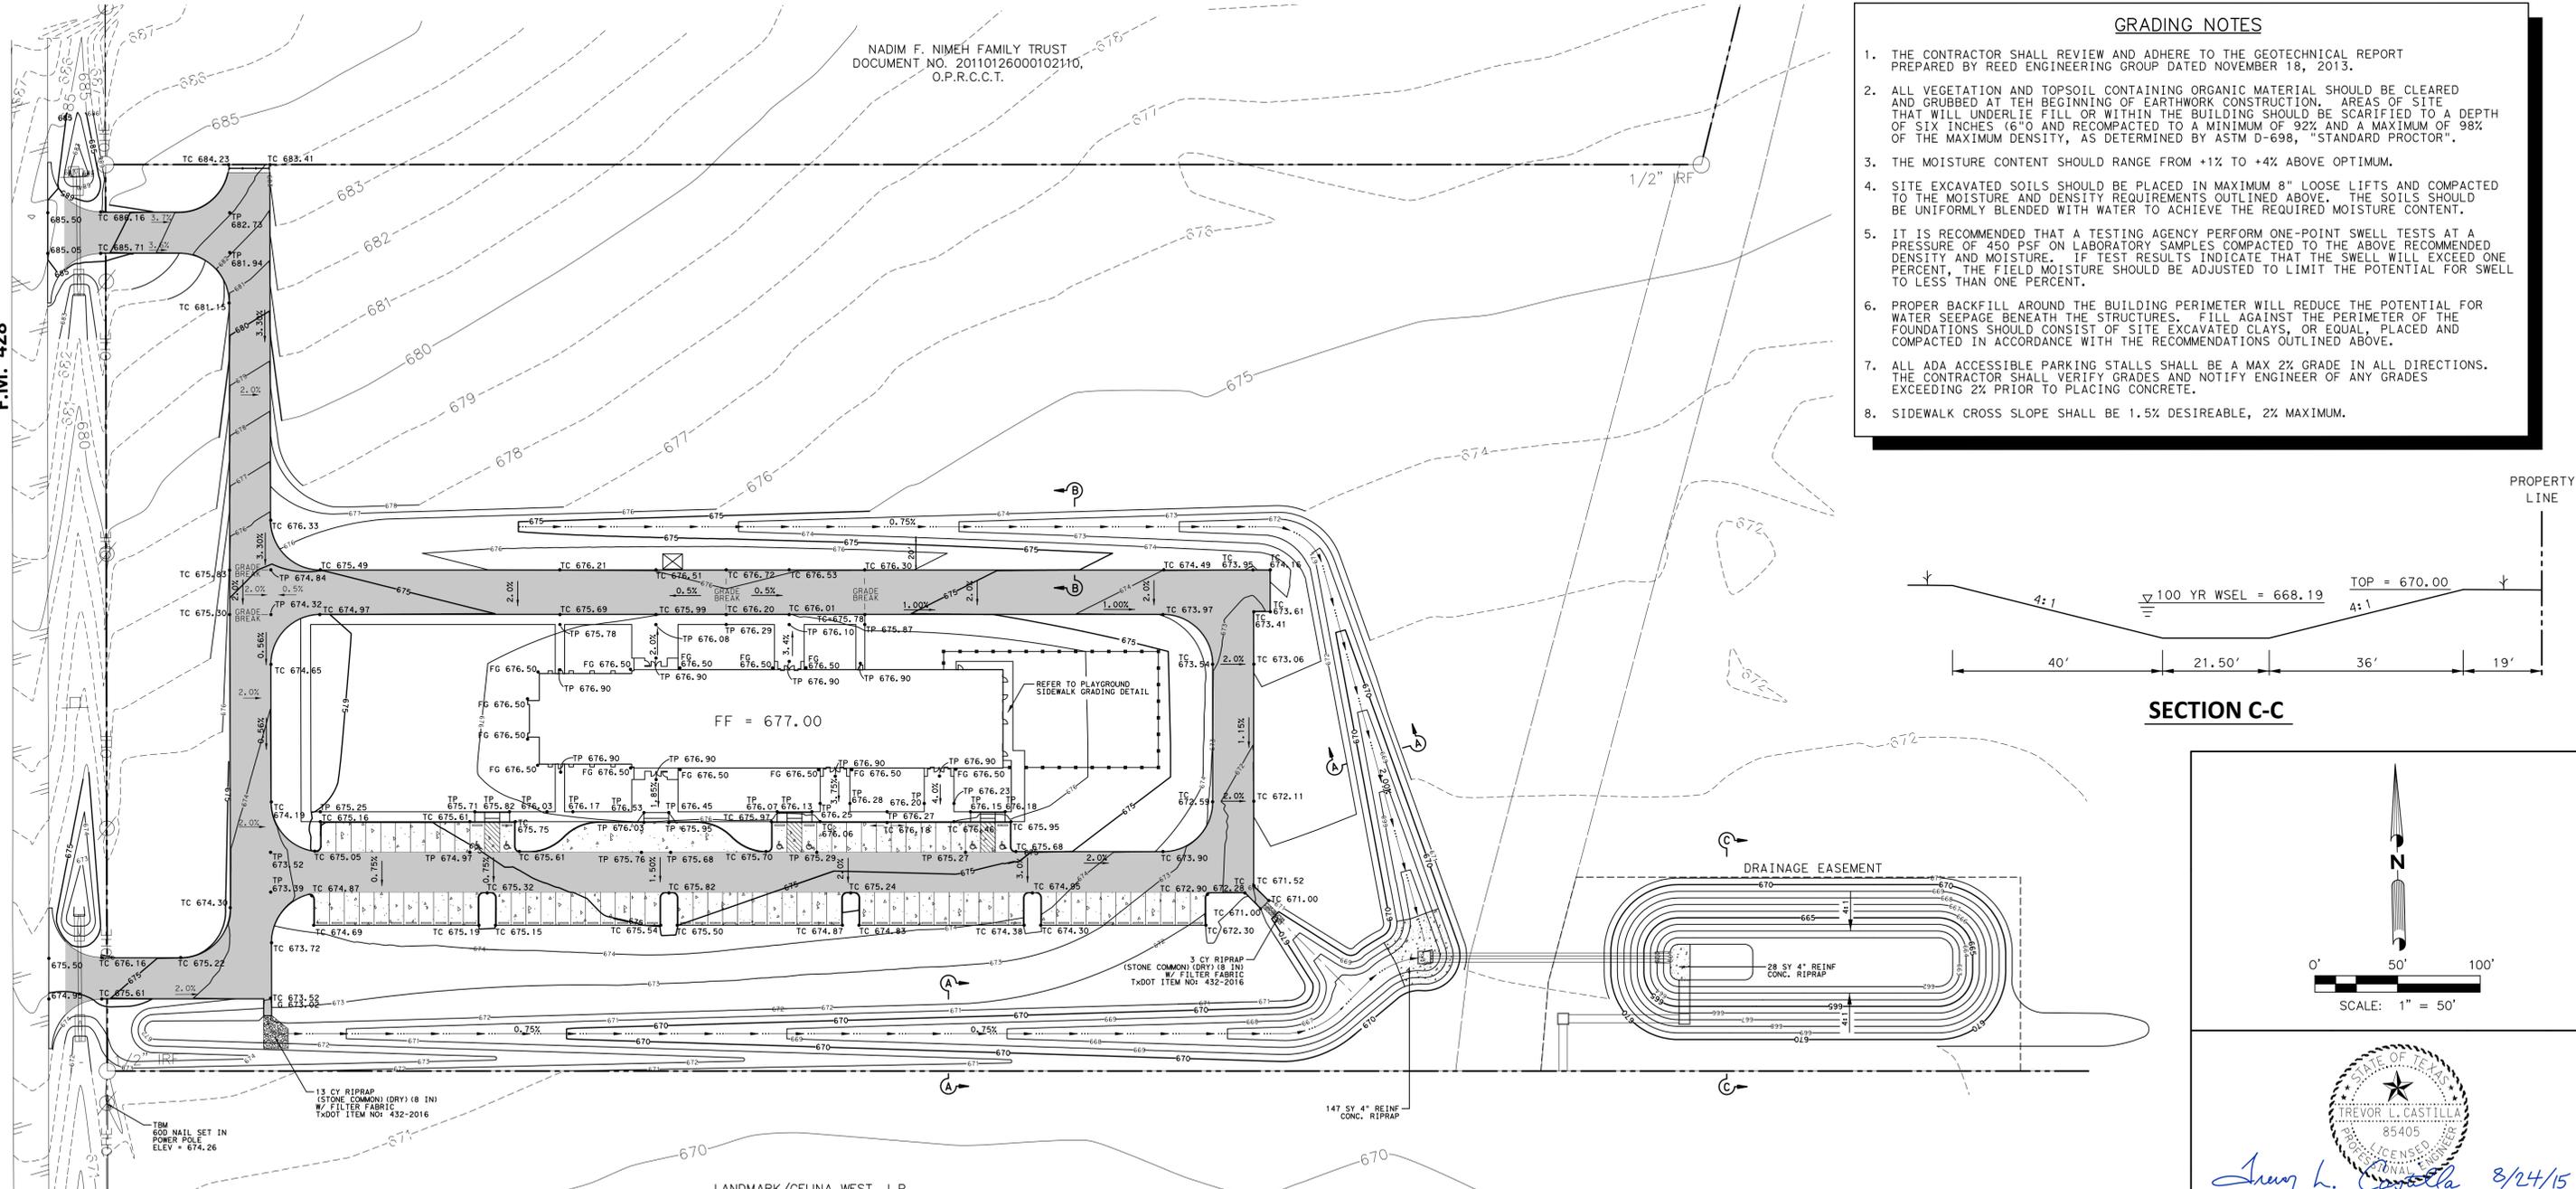

SECTION C-C

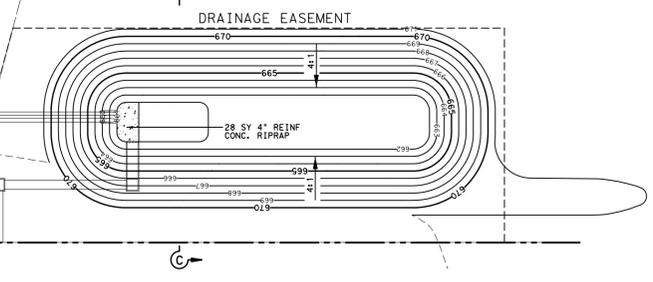


North arrow pointing up.

Graphic scale: 0' to 100'.


SCALE: 1" = 50'

Professional Engineer Seal for Trevor L. Castilla, No. 85405, State of Texas.


Angy L. Castilla 8/24/15

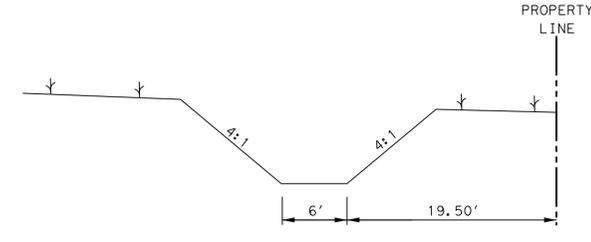

SECTION A-A

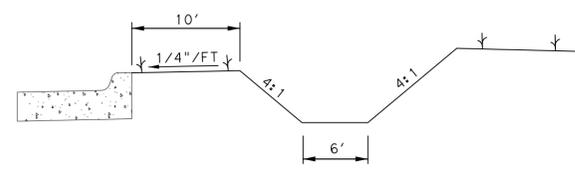

SECTION B-B

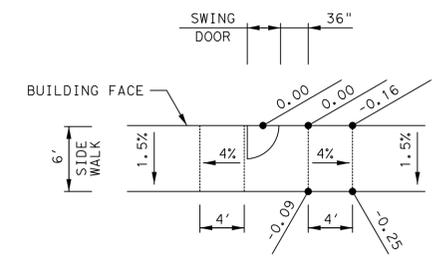

PLAYGROUND SIDEWALK GRADING DETAIL


NO.	REVISION	BY	DATE

CIVIL CONSULTING GROUP
1515 HERITAGE DRIVE, STE. 212
MCKINNEY, TEXAS 75069
P 972.569.9193 F 972.569.9197
TEXAS REGISTERED ENGINEERING FIRM NO. F-9356

**FIRST UNITED METHODIST CHURCH - CELINA
LOT 1, BLOCK A
FIRST UNITED METHODIST CHURCH ADDITION
CITY OF CELINA, COLLIN COUNTY, TEXAS**

DESIGNED- TLC	DRAWN- JRK	DATE- 8/24/2015	C-4
APPROVED- CCG	CHECKED- TLC	SCALE-	

FILENAME: FLIMC*GRADE.dgn
PLOTTED: 8/24/2015

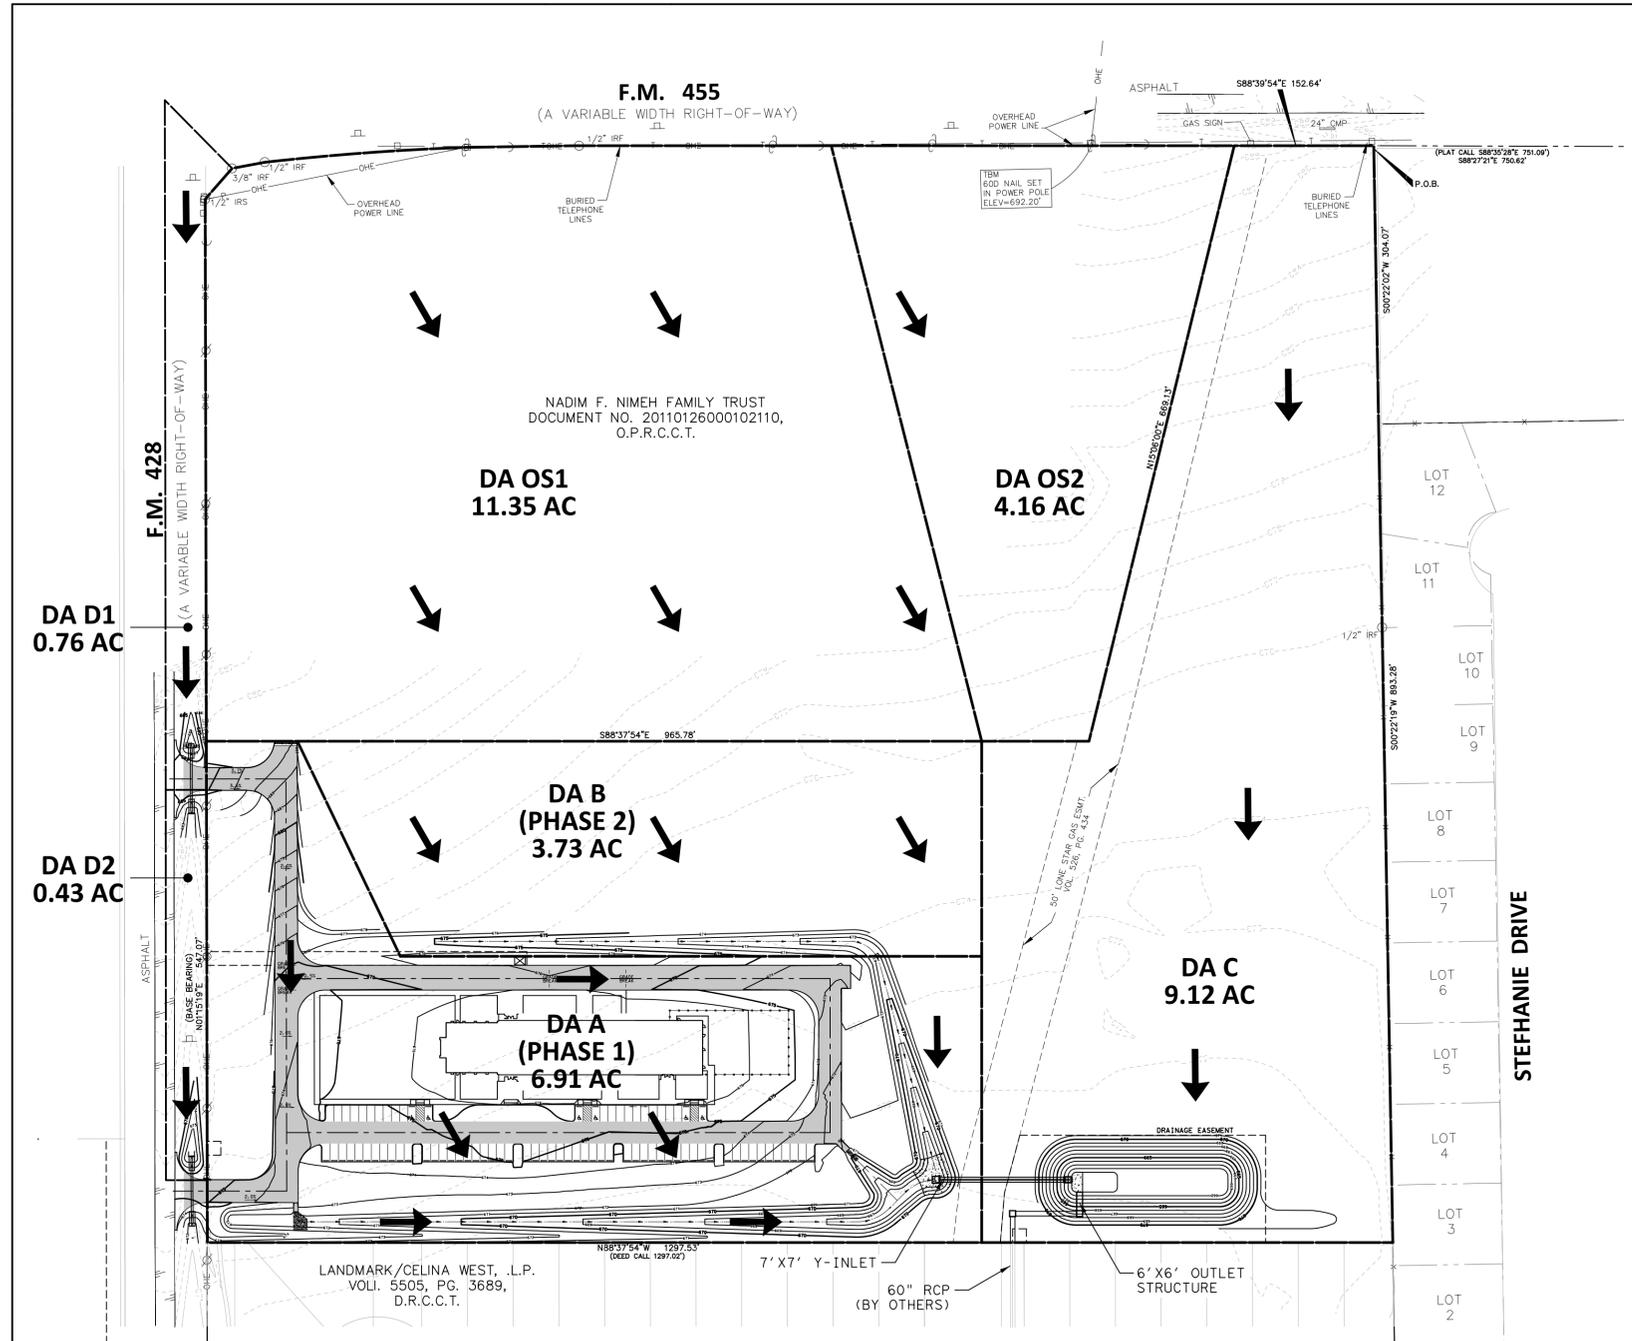

MODIFIED RATIONAL METHOD DETENTION POND DESIGN (10 YEAR)

CONDITION	WEIGHTED RUNOFF COEFF.	T (MIN)	INTENSITY (IN/HR)	AREA (AC)	RUNOFF (CFS)	OFFSITE PASS THRU RUNOFF (CFS)	COMBINED ALLOWABLE RELEASE (CFS)
EXISTING CONDITION	0.40	20	4.84	19.76	76.66	16.11	54.36
PROPOSED CONDITION	0.61	10	6.36	19.76	76.66		

TIME STEP	Td DURATION (min)	WEIGHTED RUNOFF COEFF. c	INTENSITY (IN/HR)	AREA (AC)	Q (PEAK) (CFS)	VOLUME (FT ³)		REQ. STORAGE (AC-FT)	VOLUME (AC-FT)
						INFLOW T ₀ +60	OUTFLOW 0.5(T ₀ -T _d)+60		
1	10	0.61	6.36	19.76	76.66	45996.54	22953.22	23043.32	0.53
2	15	0.61	5.46	19.76	65.81	59231.39	2891.52	30539.87	0.70
3	20	0.61	4.85	19.76	58.46	70151.95	34429.82	35722.13	0.82
4	25	0.61	4.40	19.76	53.04	79553.76	40168.13	39385.63	0.90
5	30	0.61	4.10	19.76	49.42	88955.57	45906.43	43049.14	0.99
6	35	0.61	3.85	19.76	46.41	97453.36	51644.74	45808.62	1.05
7	40	0.61	3.55	19.76	42.79	102696.67	57383.04	45313.63	1.04
8	45	0.61	3.30	19.76	39.78	107397.58	63121.34	44276.23	1.02
9	50	0.61	3.10	19.76	37.37	112098.48	68859.65	43238.83	0.99
10	55	0.61	2.90	19.76	34.96	115352.95	74597.95	40755.00	0.94
11	60	0.61	2.69	19.76	32.42	116727.06	80336.26	36390.81	0.84
12	65	0.61	2.60	19.76	31.34	122223.50	86074.56	36148.94	0.83
13	70	0.61	2.50	19.76	30.13	126562.80	91812.86	34749.94	0.80
14	75	0.61	2.40	19.76	28.93	130178.88	97551.17	32627.71	0.75
15	80	0.61	2.29	19.76	27.60	132493.17	103289.47	29203.70	0.67
16	85	0.61	2.22	19.76	26.76	136470.86	109027.78	27443.08	0.63
17	90	0.61	2.15	19.76	25.92	139942.30	114766.08	25176.22	0.58

MODIFIED RATIONAL METHOD DETENTION POND DESIGN (100 YEAR)

CONDITION	WEIGHTED RUNOFF COEFF.	T (MIN)	INTENSITY (IN/HR)	AREA (AC)	RUNOFF (CFS)	OFFSITE PASS THRU RUNOFF (CFS)	COMBINED ALLOWABLE RELEASE (CFS)
EXISTING CONDITION	0.40	20	6.78	19.76	53.59	42.06	95.65
PROPOSED CONDITION	0.61	10	8.74	19.76	105.35		

TIME STEP	Td DURATION (min)	WEIGHTED RUNOFF COEFF. c	INTENSITY (IN/HR)	AREA (AC)	Q (PEAK) (CFS)	VOLUME (FT ³)		REQ. STORAGE (AC-FT)	VOLUME (AC-FT)
						INFLOW T ₀ +60	OUTFLOW 0.5(T ₀ -T _d)+60		
1	10	0.61	8.74	19.76	105.35	63209.08	32153.47	31055.61	0.71
2	15	0.61	7.52	19.76	90.64	81578.76	40191.84	41386.92	0.95
3	20	0.61	6.78	19.76	81.72	98068.09	48230.21	49837.88	1.14
4	25	0.61	6.20	19.76	74.73	112098.48	56266.58	55829.90	1.28
5	30	0.61	5.75	19.76	69.31	124754.76	64306.94	60477.82	1.39
6	35	0.61	5.50	19.76	66.29	139219.08	72345.31	66873.77	1.54
7	40	0.61	5.10	19.76	61.47	147536.06	80383.68	67152.38	1.54
8	45	0.61	4.70	19.76	56.65	152960.18	88422.05	64538.14	1.48
9	50	0.61	4.45	19.76	53.64	160915.56	96460.42	64455.14	1.48
10	55	0.61	4.20	19.76	50.63	167062.90	104498.78	62564.11	1.44
11	60	0.61	3.91	19.76	47.13	169666.47	112537.15	57129.32	1.31
12	65	0.61	3.80	19.76	45.80	178634.35	120575.52	58056.83	1.33
13	70	0.61	3.65	19.76	44.00	184781.69	128613.89	56167.80	1.29
14	75	0.61	3.50	19.76	42.19	189844.20	136652.26	53191.94	1.22
15	80	0.61	3.35	19.76	40.38	193821.89	144690.62	49131.26	1.13
16	85	0.61	3.25	19.76	39.17	199788.42	152728.99	47059.43	1.08
17	90	0.61	3.15	19.76	37.97	205031.74	160767.36	44264.38	1.02

HYDROLOGIC CALCULATIONS (10 YEAR)

AREA NUMBER	DRAINAGE AREA (ACRES)	RUNOFF COEFF. (c)	TIME OF CONCENTRATION (MIN)	INTENSITY (IN/HR)	RUNOFF Q (CFS)
PRE-DEVELOPMENT					
A	6.91	0.40	20	4.84	13.38
B	3.73	0.40	20	4.84	7.22
C	9.12	0.40	20	4.84	17.66
D1	0.76	0.40	10	6.36	1.93
D2	0.43	0.40	10	6.36	1.09
OS1	11.35	0.40	20	4.84	8.05
OS2	4.16	0.40	20	4.84	8.05
ALLOWABLE RELEASE RATE (10 YEAR) (AREAS A, B, C, OS1, OS2)					
54.36					
POST DEVELOPMENT					
A	6.91	0.80	10	6.36	35.16
B	3.73	0.80	10	6.36	18.98
C	9.12	0.40	20	4.84	17.66
D1	0.76	0.40	10	6.36	1.93
D2	0.43	0.40	10	6.36	1.09
OS1	11.35	0.40	20	4.84	21.97
OS2	4.16	0.40	20	4.84	8.05

HYDROLOGIC CALCULATIONS (100 YEAR)

AREA NUMBER	DRAINAGE AREA (ACRES)	RUNOFF COEFF. (c)	TIME OF CONCENTRATION (MIN)	INTENSITY (IN/HR)	RUNOFF Q (CFS)
PRE-DEVELOPMENT					
A	6.91	0.40	20	6.78	18.74
B	3.73	0.40	20	6.78	10.12
C	9.12	0.40	20	6.78	24.73
D1	0.76	0.40	10	8.74	2.66
D2	0.43	0.40	10	8.74	1.50
OS1	11.35	0.40	20	6.78	30.78
OS2	4.16	0.40	20	6.78	11.28
ALLOWABLE RELEASE RATE (100 YEAR) (AREAS A, B, C, OS1, OS2)					
95.65					
POST DEVELOPMENT					
A	6.91	0.80	10	8.74	48.31
B	3.73	0.80	10	8.74	26.08
C	9.12	0.40	20	6.78	24.73
D1	0.76	0.40	10	8.74	2.66
D2	0.43	0.40	10	8.74	1.50
OS1	11.35	0.40	20	6.78	30.78
OS2	4.16	0.40	20	6.78	11.28



DETENTION POND OUTLET CALCULATIONS			
Weir Equation	$Q = cbr^{3/2}$	Orifice Equation	$Q = ca(2gh)^{3/2}$
Q	Runoff (cfs)	Q	Runoff (cfs)
c	Coefficient	c	Coefficient
b	Weir base width	A	Opening Area (ft ²)
h	Water height above weir	g	32.2 ft/s ²
		h	Water depth above centroid of opening


BASE OPENING		SECONDARY OPENING	
Opening base width (ft) =	2.000	Opening base width (ft) =	4.500
Opening height (ft) =	1.250	Opening height (ft) =	2.000
Area (sf) =	2.50	Area (sf) =	9.00
Base Elevation (ft) =	660.75	Base Elevation (ft) =	666.00
Weir Coefficient =	3.00	Weir Coefficient =	3.00
Orifice Coefficient =	0.60	Orifice Coefficient =	0.60

DETENTION POND WSEL (ft)	WEIR FLOW		ORIFICE FLOW		WEIR FLOW		ORIFICE FLOW		COMBINED RUNOFF (cfs)
	HEIGHT (ft)	RUNOFF (cfs)	HEIGHT (ft)	RUNOFF (cfs)	HEIGHT (ft)	RUNOFF (cfs)	HEIGHT (ft)	RUNOFF (cfs)	
660.75	0.00	0.0	0.00	0.0	0.00	0.0	0.00	0.0	0.0
661.00	0.25	0.8	0.00	0.0	0.00	0.0	0.00	0.0	0.8
661.50	0.75	3.9	0.00	0.0	0.00	0.0	0.00	0.0	3.9
662.00	1.25	8.4	0.63	9.5	0.00	0.0	0.00	0.0	8.4
662.50	0.00	0.0	1.13	12.8	0.00	0.0	0.00	0.0	12.8
663.00	0.00	0.0	1.63	15.3	0.00	0.0	0.00	0.0	15.3
663.50	0.00	0.0	2.13	17.5	0.00	0.0	0.00	0.0	17.5
664.00	0.00	0.0	2.63	19.5	0.00	0.0	0.00	0.0	19.5
664.50	0.00	0.0	3.13	21.3	0.00	0.0	0.00	0.0	21.3
665.00	0.00	0.0	3.63	22.9	0.00	0.0	0.00	0.0	22.9
665.50	0.00	0.0	4.13	24.4	0.00	4.8	0.00	0.0	29.2
666.00	0.00	0.0	4.63	25.9	1.00	13.5	0.00	0.0	39.4
666.50	0.00	0.0	5.13	27.3	1.50	24.8	0.00	0.0	52.1
666.58	0.00	0.0	5.21	27.5	1.58	26.8	0.00	0.0	54.3
667.00	0.00	0.0	5.63	28.5	2.00	38.2	1.00	43.3	66.7
667.50	0.00	0.0	6.13	29.8	2.50	53.4	1.50	53.1	82.9
668.00	0.00	0.0	6.63	31.0	0.00	0.0	2.00	61.3	92.3
668.19	0.00	0.0	6.82	31.4	0.00	0.0	2.19	64.1	95.6
668.50	0.00	0.0	7.13	32.1	0.00	0.0	2.50	68.5	100.6
669.00	0.00	0.0	7.63	33.2	0.00	0.0	3.00	75.1	108.3

Y-INLET CALCULATIONS			
Opening base width (ft) =	28.000		
Opening height (ft) =	1.000		
Area (sf) =	28.00		
Base Elevation (ft) =	666.00		
Weir Coefficient =	3.00		
Orifice Coefficient =	0.60		

HEAD ELEVATION (ft)	WEIR FLOW		ORIFICE FLOW		AREA NUMBER	DRAINAGE AREA (ACRES)	RUNOFF COEFF. (c)	TIME OF CONCENTRATION (MIN)	INTENSITY (IN/HR)	RUNOFF Q (CFS)
	HEIGHT (ft)	RUNOFF (cfs)	HEIGHT (ft)	RUNOFF (cfs)						
666.00	0.00	0.0	0.00	0.0						
666.25	0.25	10.5	0.00	0.0						
666.50	0.50	29.7	0.00	0.0						
666.75	0.75	54.6	0.00	0.0						
667.00	1.00	84.0	0.50	95.3						
667.11	1.11	98.2	0.61	105.3						
667.50	0.00	0.0	1.00	134.8						
667.75	0.00	0.0	1.25	150.7						
668.00	0.00	0.0	1.50	165.1						

Y-INLET HYDROLOGIC CALCULATIONS (100 YEAR)										
POST DEVELOPMENT										
A	6.91	0.80	10	8.74	48.31					
B	3.73	0.80	10	8.74	26.08					
C	9.12	0.40	20	6.78	24.73					
D1	0.76	0.40	10	8.74	2.66					
D2	0.43	0.40	10	8.74	1.50					
OS1	11.35	0.40	20	6.78	30.78					
OS2	4.16	0.40	20	6.78	11.28					

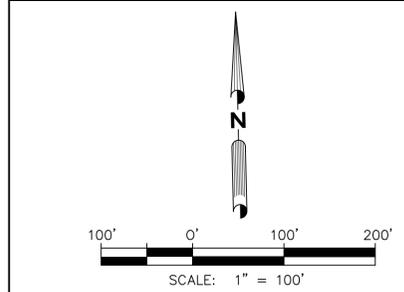

STATE OF TEXAS
 TREVOR L. CASTILLA
 85405
 LICENSED PROFESSIONAL ENGINEER
 August L. Castella 8/24/15

CIVIL CONSULTING GROUP
 1515 HERITAGE DRIVE, STE. 212
 MCKINNEY, TEXAS 75069
 P 972.569.9193 F 972.569.9197
 TEXAS REGISTERED ENGINEERING FIRM NO. F-9356


FIRST UNITED METHODIST CHURCH - CELINA
 LOT 1, BLOCK A
 FIRST UNITED METHODIST CHURCH ADDITION
 CITY OF CELINA, COLLIN COUNTY, TEXAS

DRAINAGE AREA MAP


DESIGNED- TLC DRAWN- JRK DATE- 8/24/2015
 APPROVED- CCG CHECKED- TLC SCALE- **C = 5**

FILENAME: FLIMC*DAMAP.dgn
 PLOTTED: 8/24/2015

FILENAME: FLMIC*DRAIN.dgn
 PLOTTED: 8/24/2015

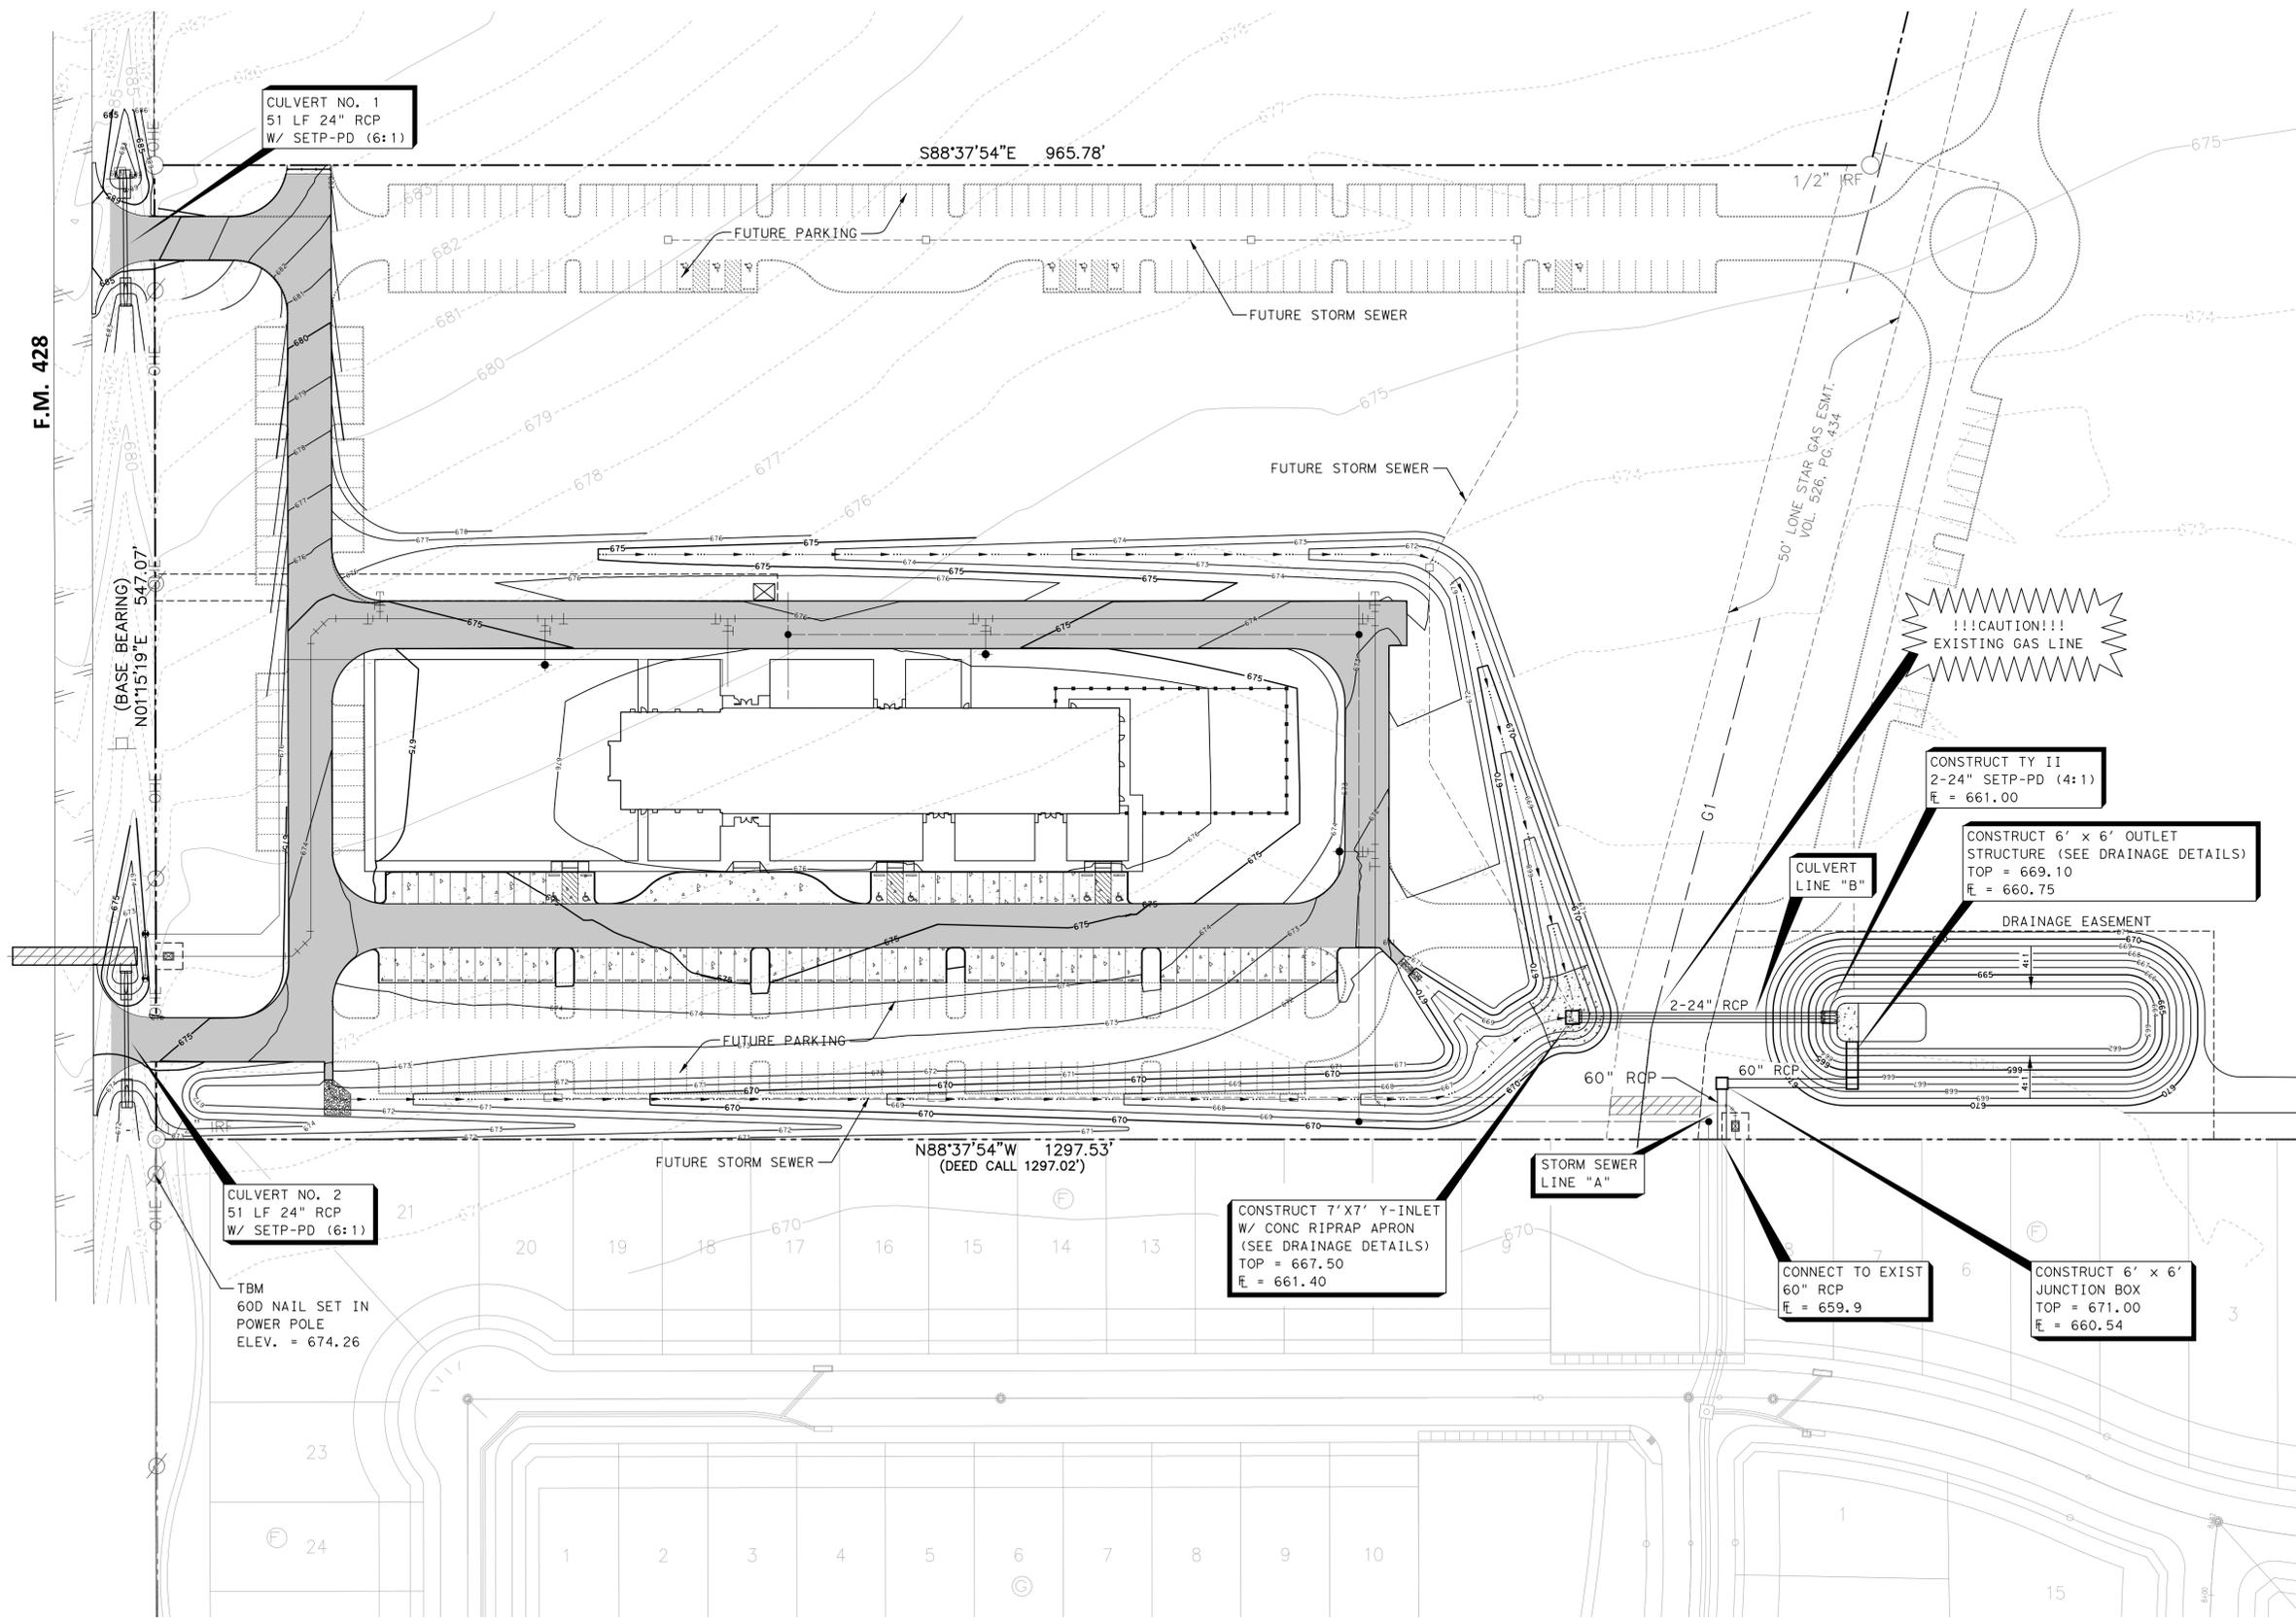

F.M. 428

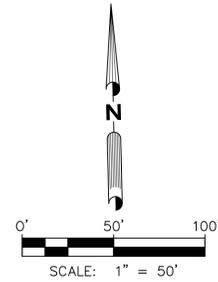

STATE OF TEXAS
 TREVOR L. CASTILLA
 85405
 LICENSED PROFESSIONAL ENGINEER
Angy L. Castella 8/24/15

NO.	REVISION	BY	DATE

CC CIVIL CONSULTING GROUP
 1515 HERITAGE DRIVE, STE. 212
 MCKINNEY, TEXAS 75069
 P 972.569.9193 F 972.569.9197
 TEXAS REGISTERED ENGINEERING FIRM NO. F-9356


**FIRST UNITED METHODIST CHURCH - CELINA
 LOT 1, BLOCK A
 FIRST UNITED METHODIST CHURCH ADDITION
 CITY OF CELINA, COLLIN COUNTY, TEXAS**

DRAINAGE PLAN

DESIGNED- TLC	DRAWN- JRK	DATE- 8/24/2015	C = 6
APPROVED- CCG	CHECKED- TLC	SCALE- 1"=50'	

P-201504-01

FILENAME: FUMC-DRAIN.dgn
 PLOTTED: 8/26/2015

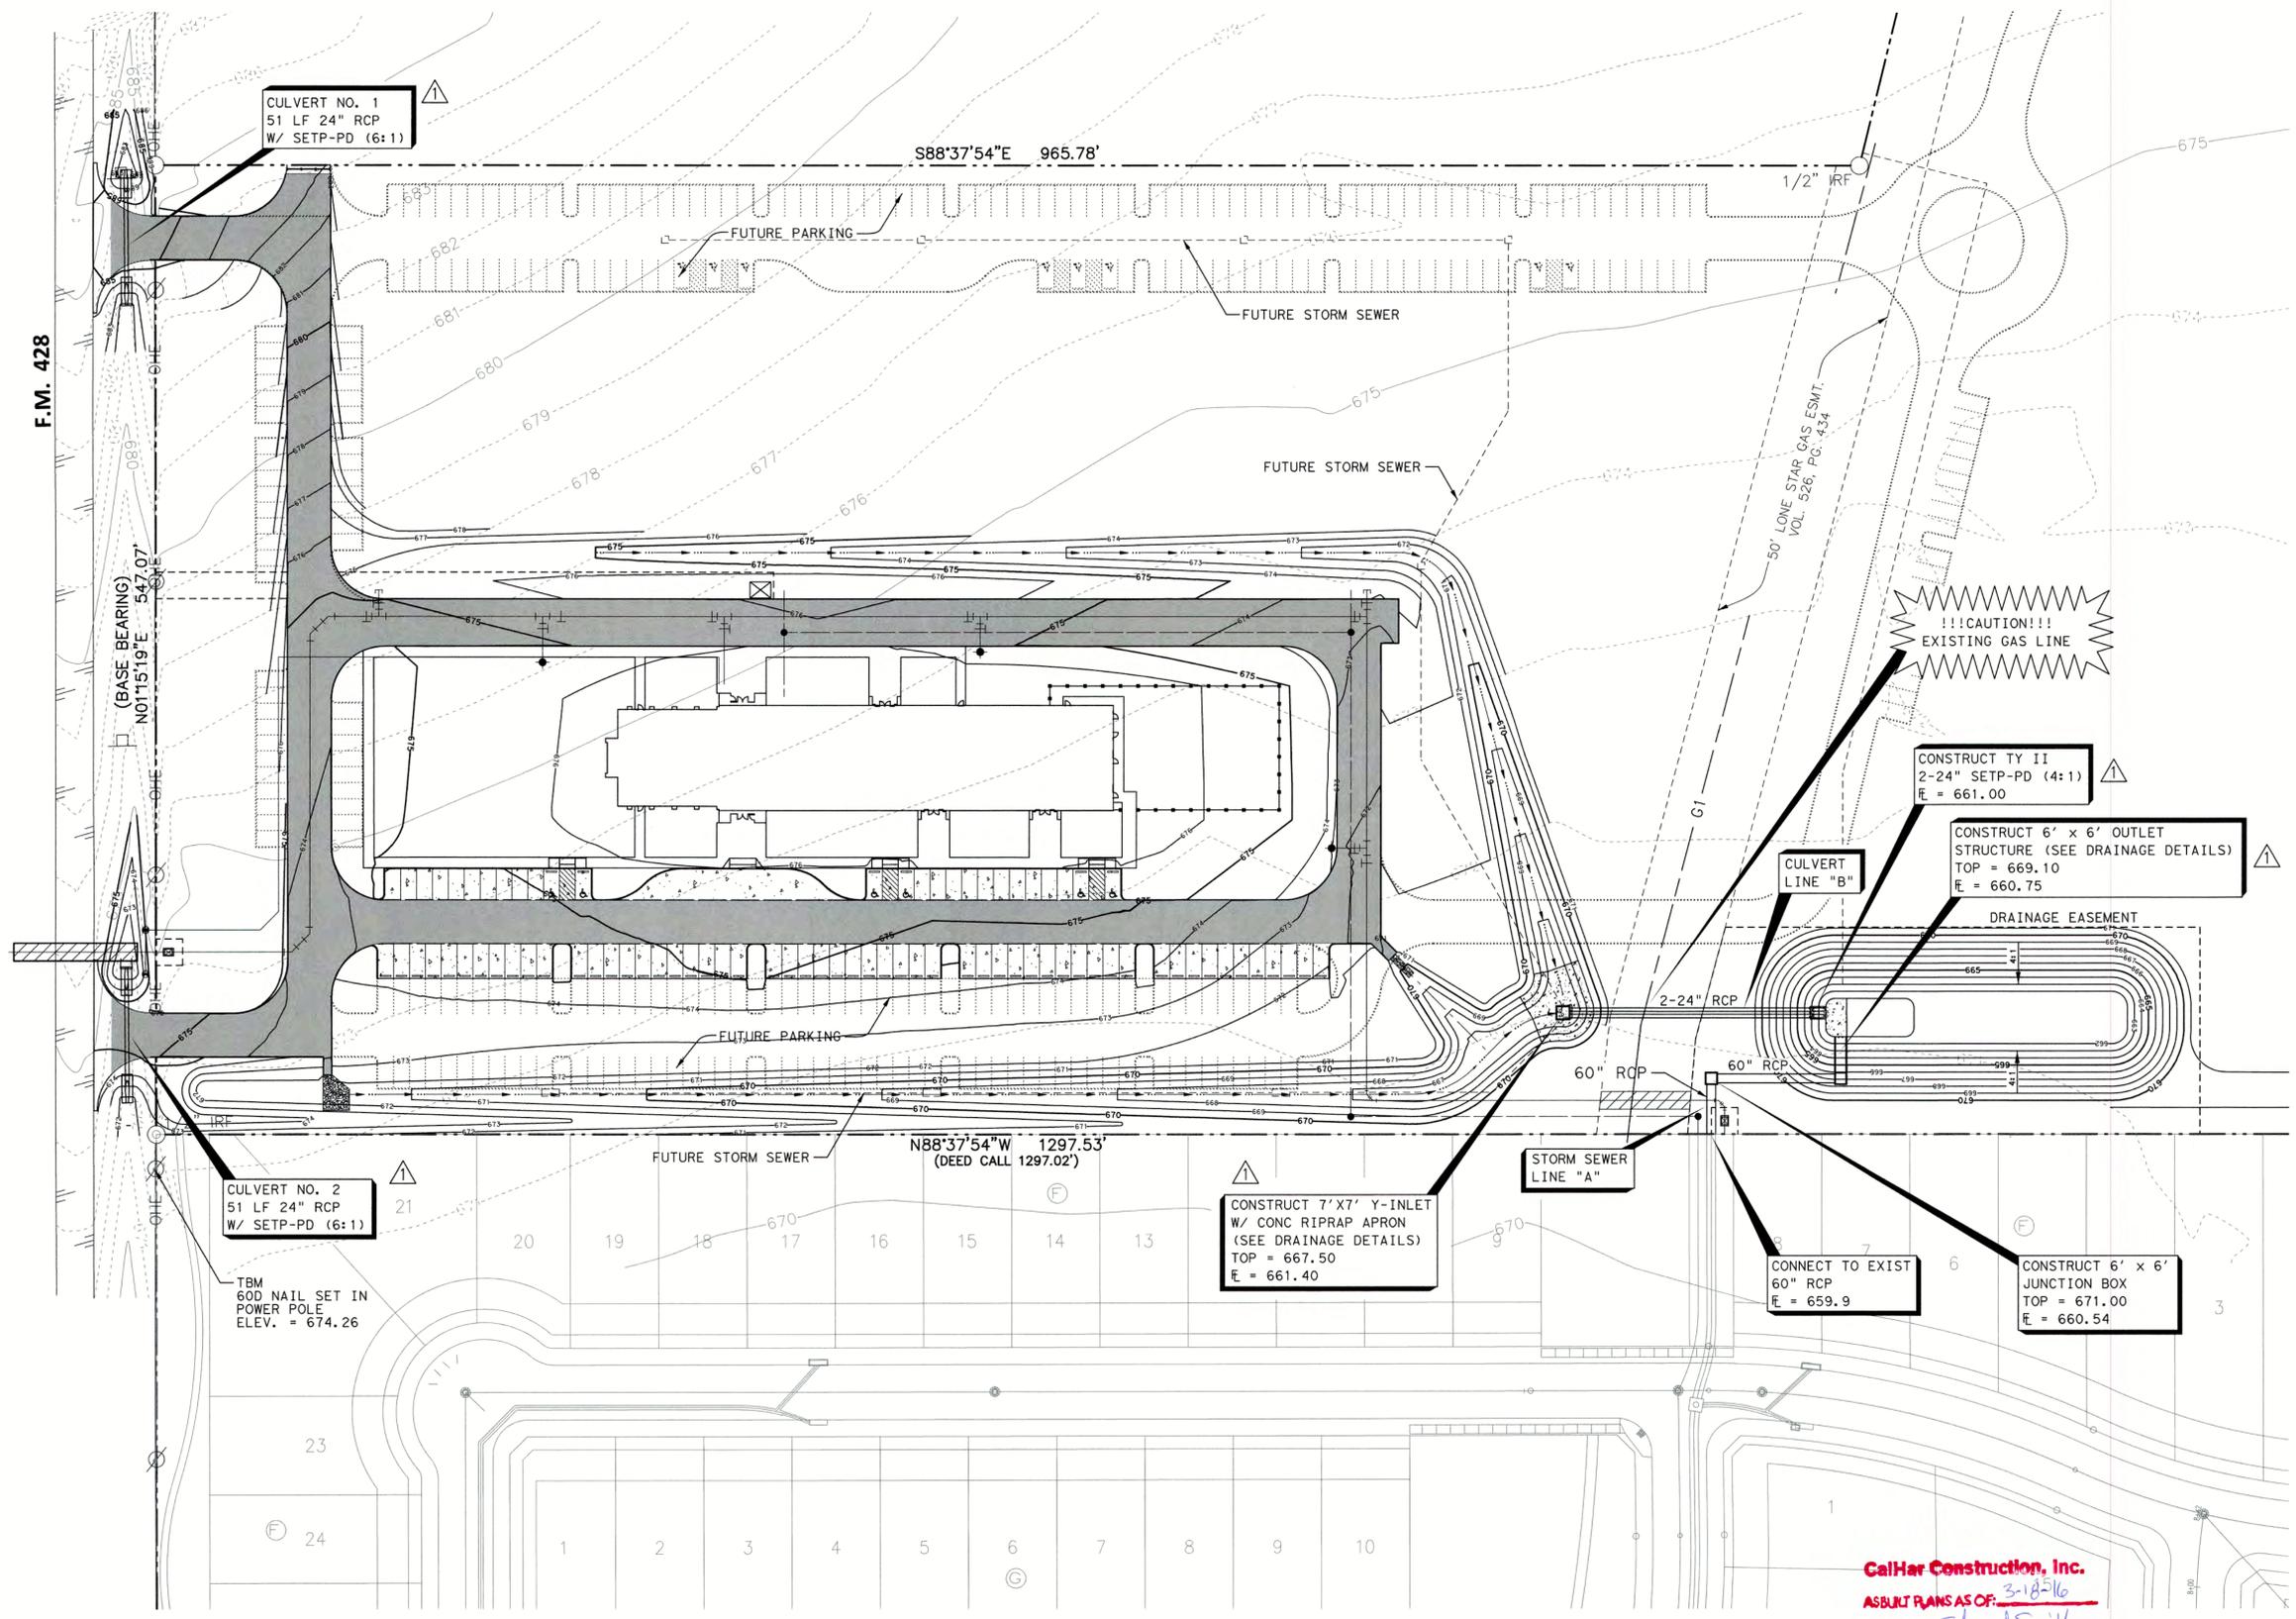

F.M. 428

CULVERT NO. 1
 51 LF 24" RCP
 W/ SETP-PD (6:1)

CULVERT NO. 2
 51 LF 24" RCP
 W/ SETP-PD (6:1)

CONSTRUCT 7'x7' Y-INLET
 W/ CONC RIPRAP APRON
 (SEE DRAINAGE DETAILS)
 TOP = 667.50
 E = 661.40


CONSTRUCT TY II
 2-24" SETP-PD (4:1)
 E = 661.00

CONSTRUCT 6' x 6' OUTLET
 STRUCTURE (SEE DRAINAGE DETAILS)
 TOP = 669.10
 E = 660.75

CONNECT TO EXIST
 60" RCP
 E = 659.9

CONSTRUCT 6' x 6'
 JUNCTION BOX
 TOP = 671.00
 E = 660.54

!!!CAUTION!!!
 EXISTING GAS LINE

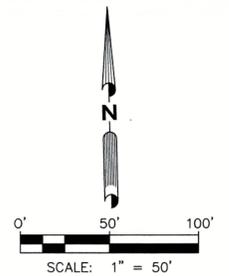

Trevor L. Castilla 8/24/15

NO.	CITY REVIEW COMMENTS/MISC REVISIONS	TLC	8/24/15
NO.	REVISION	BY	DATE

CCG CIVIL CONSULTING GROUP
 1515 HERITAGE DRIVE, STE. 212
 MCKINNEY, TEXAS 75069
 P 972.569.9193 F 972.569.0197
 TEXAS REGISTERED ENGINEERING FIRM NO. F-9356


FIRST UNITED METHODIST CHURCH - CELINA
 LOT 1, BLOCK A
 FIRST UNITED METHODIST CHURCH ADDITION
 CITY OF CELINA, COLLIN COUNTY, TEXAS

DRAINAGE PLAN


CalHer Construction, Inc.
 ASUILT RANS AS OF: 3-18-16
 SIGNED BY: *Edward Smith*
 No Changes

DESIGNED- TLC	DRAWN- JRK	DATE- 8/26/2015	C-6
APPROVED- CCG	CHECKED- TLC	SCALE- 1"=50'	


P-201504-01

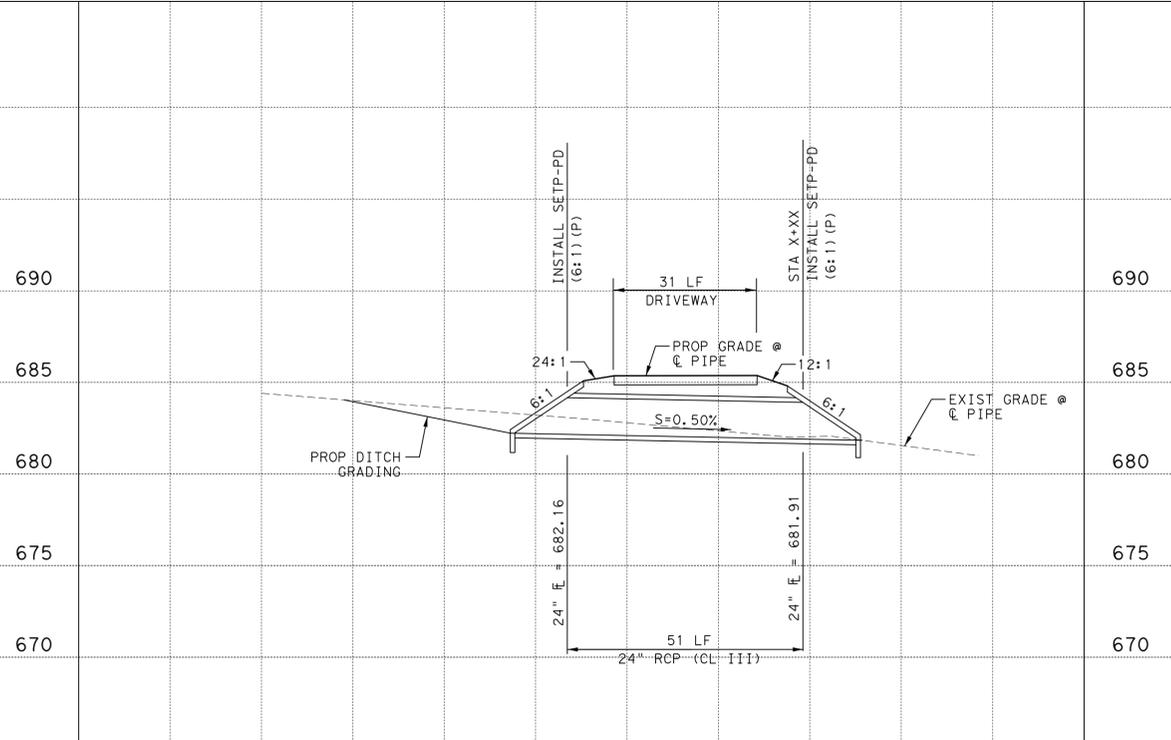


CULVERT NO. 1 PROFILE
SCALE
H: 1" = 40', V: 1" = 10'

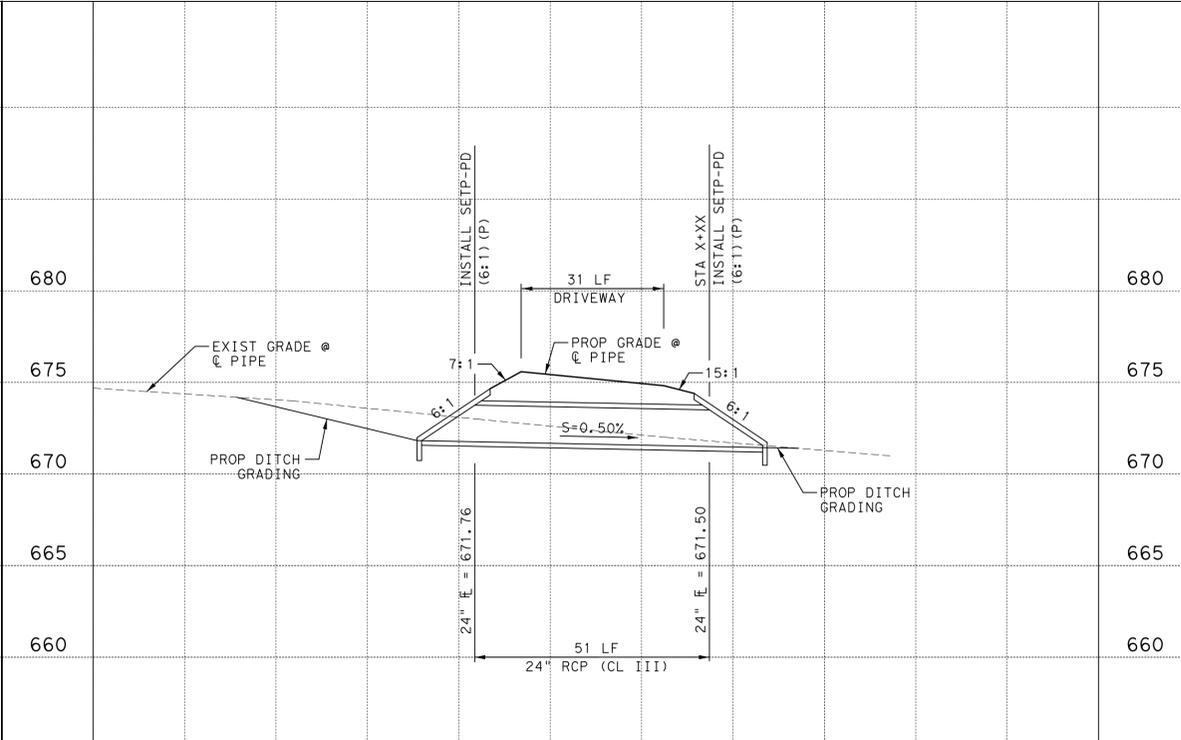


CULVERT NO. 2 PROFILE
SCALE
H: 1" = 40', V: 1" = 10'

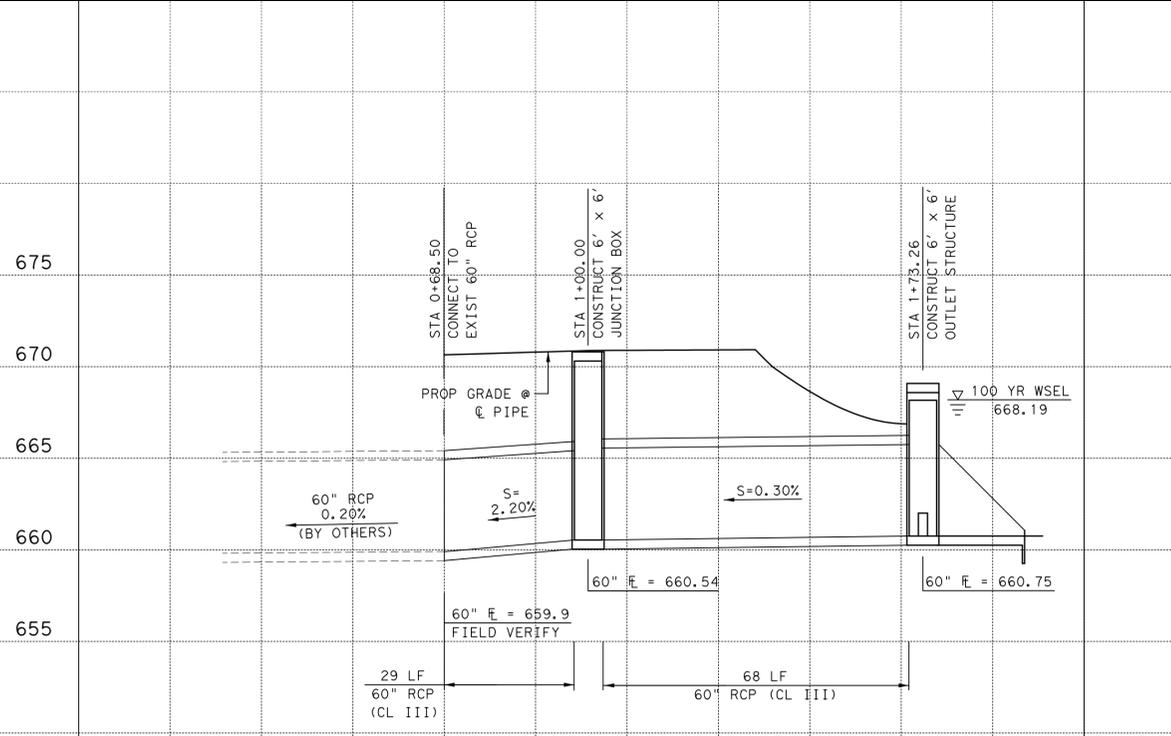

STORM SEWER LINE "A" PROFILE
SCALE
H: 1" = 40', V: 1" = 10'

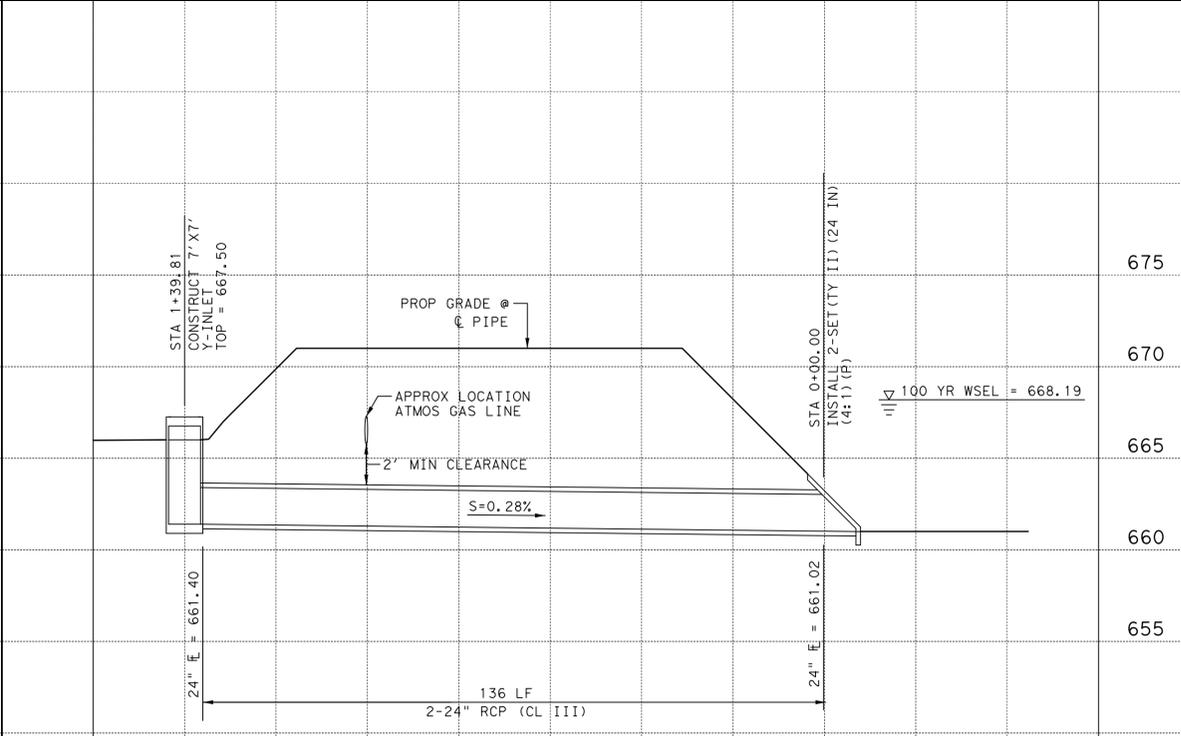

STORM SEWER LINE "B" PROFILE
SCALE
H: 1" = 40', V: 1" = 10'

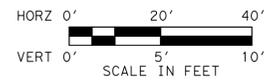

Trevor L. Castilla 8/24/15

NO.	REVISION	BY	DATE



CIVIL CONSULTING GROUP
1515 HERITAGE DRIVE, STE. 212
MCKINNEY, TEXAS 75069
P 972.569.9193 F 972.569.9197
TEXAS REGISTERED ENGINEERING FIRM NO. F-9356

**FIRST UNITED METHODIST CHURCH - CELINA
LOT 1, BLOCK A
FIRST UNITED METHODIST CHURCH ADDITION
CITY OF CELINA, COLLIN COUNTY, TEXAS**

STORM SEWER PROFILES


DESIGNED- TLC	DRAWN- JRK	DATE- 8/24/2015
APPROVED- CCG	CHECKED- TLC	SCALE-

C-7

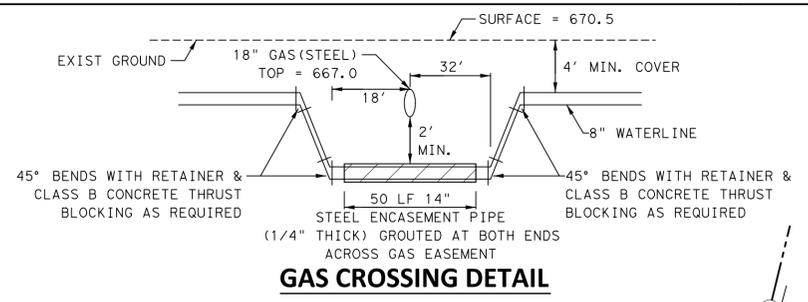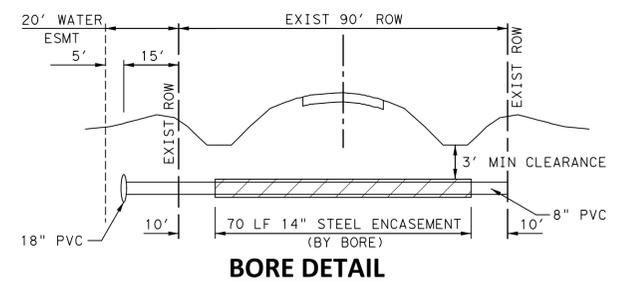

LEGEND	
	PROP WATER LINE
	PROP SAN SEW MAIN
	PROP STORM SEWER
	FIRE HYDRANT
	TEE
	VALVE
	PLUG

NOTE:
1. UTILITIES SHALL BE CONSTRUCTED TO WITHIN 5' OF BUILDING FACE.

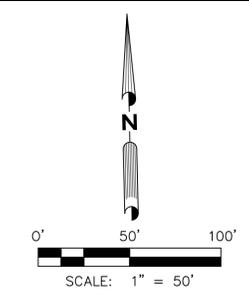

Professional Engineer seal for Trevor L. Castilla, State of Texas, License No. 85405. Signature of Trevor L. Castilla dated 8/24/15.

CIVIL CONSULTING GROUP logo and address: 1515 HERITAGE DRIVE, STE. 212 MCKINNEY, TEXAS 75069. P 972.569.9193 F 972.569.9197. TEXAS REGISTERED ENGINEERING FIRM NO. F-9356.



FIRST UNITED METHODIST CHURCH - CELINA
LOT 1, BLOCK A
FIRST UNITED METHODIST CHURCH ADDITION
CITY OF CELINA, COLLIN COUNTY, TEXAS

UTILITY PLAN

DESIGNED- TLC	DRAWN- JRK	DATE- 8/24/2015	C = 8
APPROVED- CCG	CHECKED- TLC	SCALE- 1"=50'	


FILENAME: FLUMC*UTIL.dgn
PLOTTED: 8/24/2015

FILENAME: F:\M\C*SS\PROF.dgn
 PLOTTED: 8/24/2015

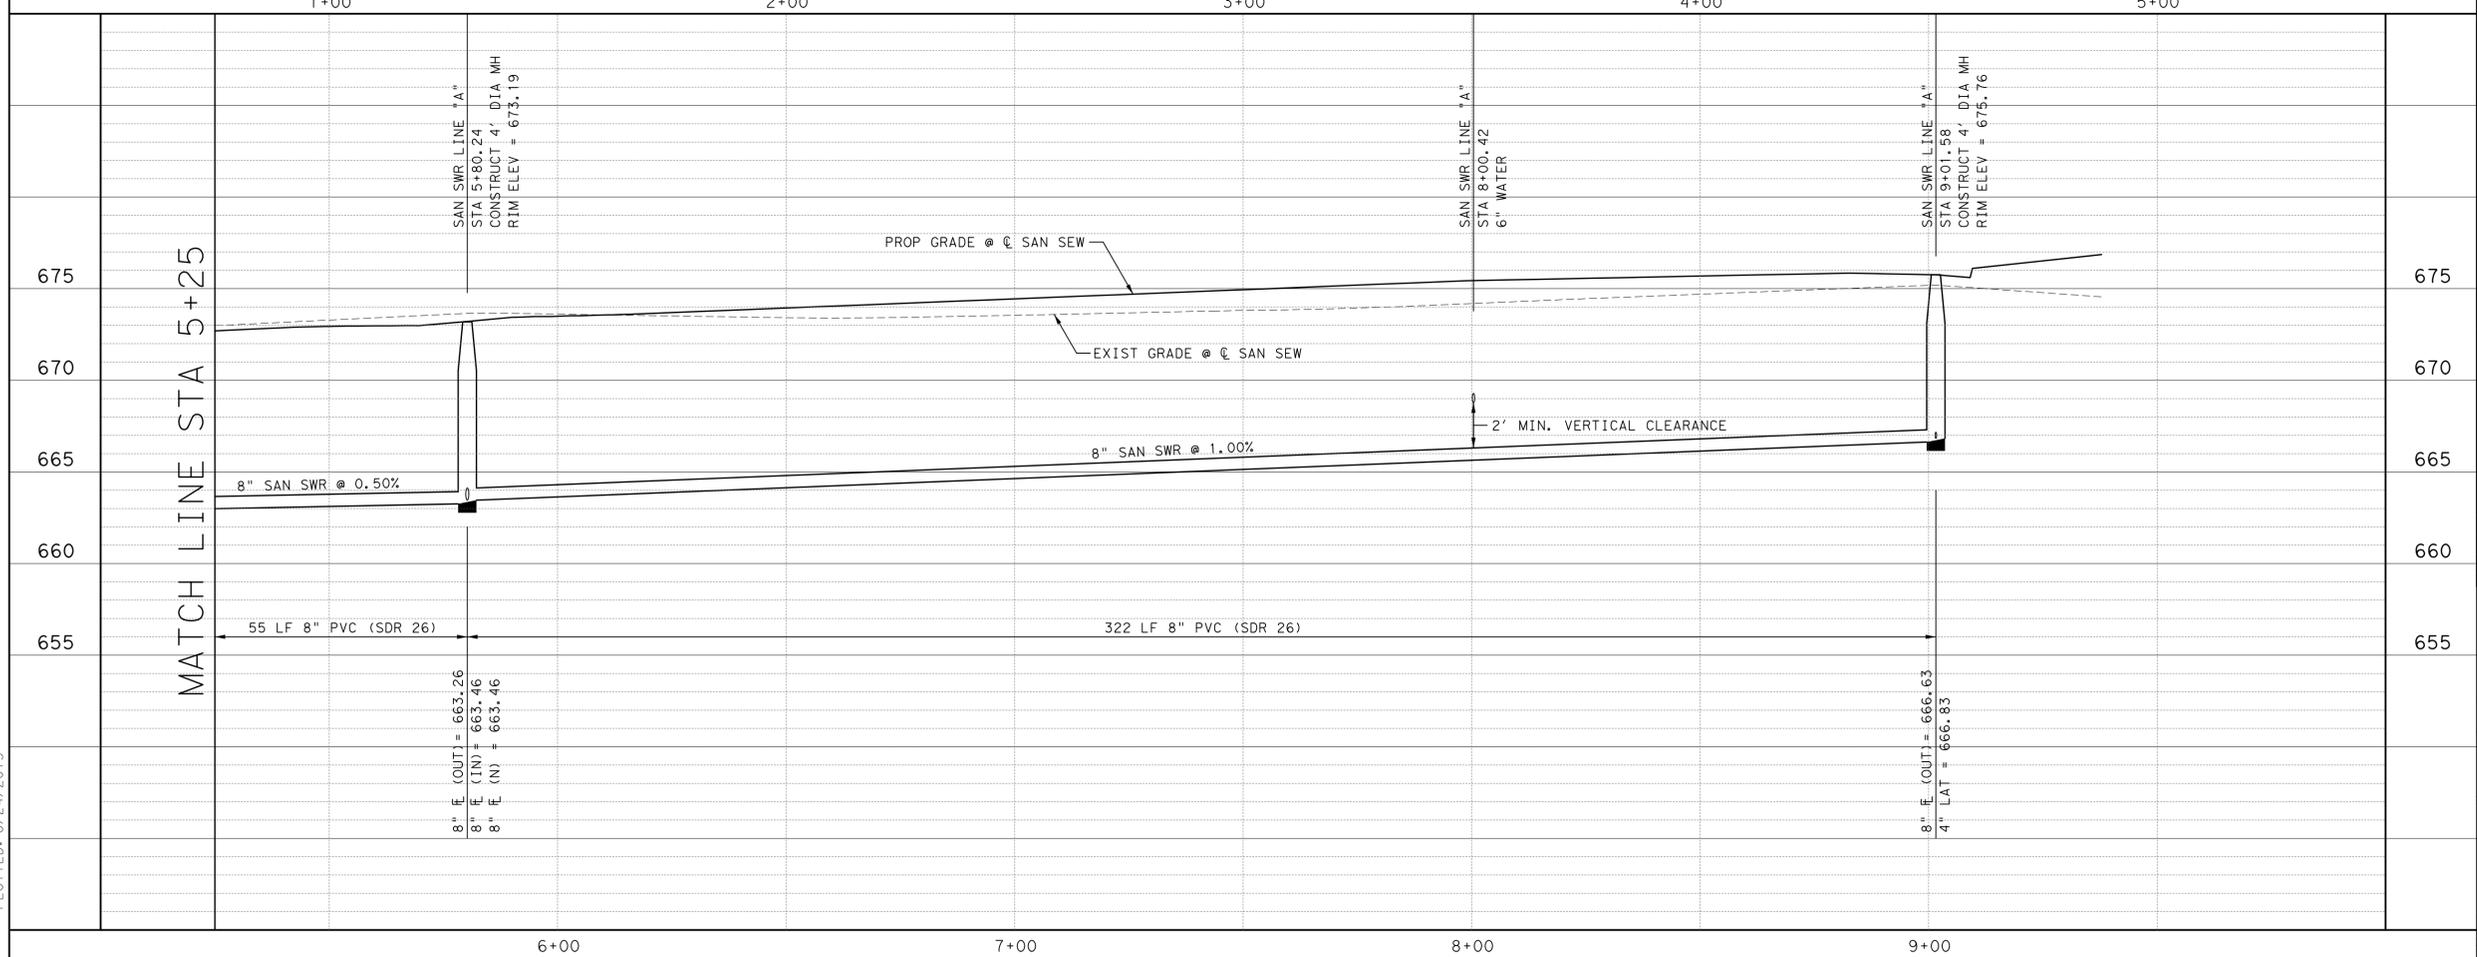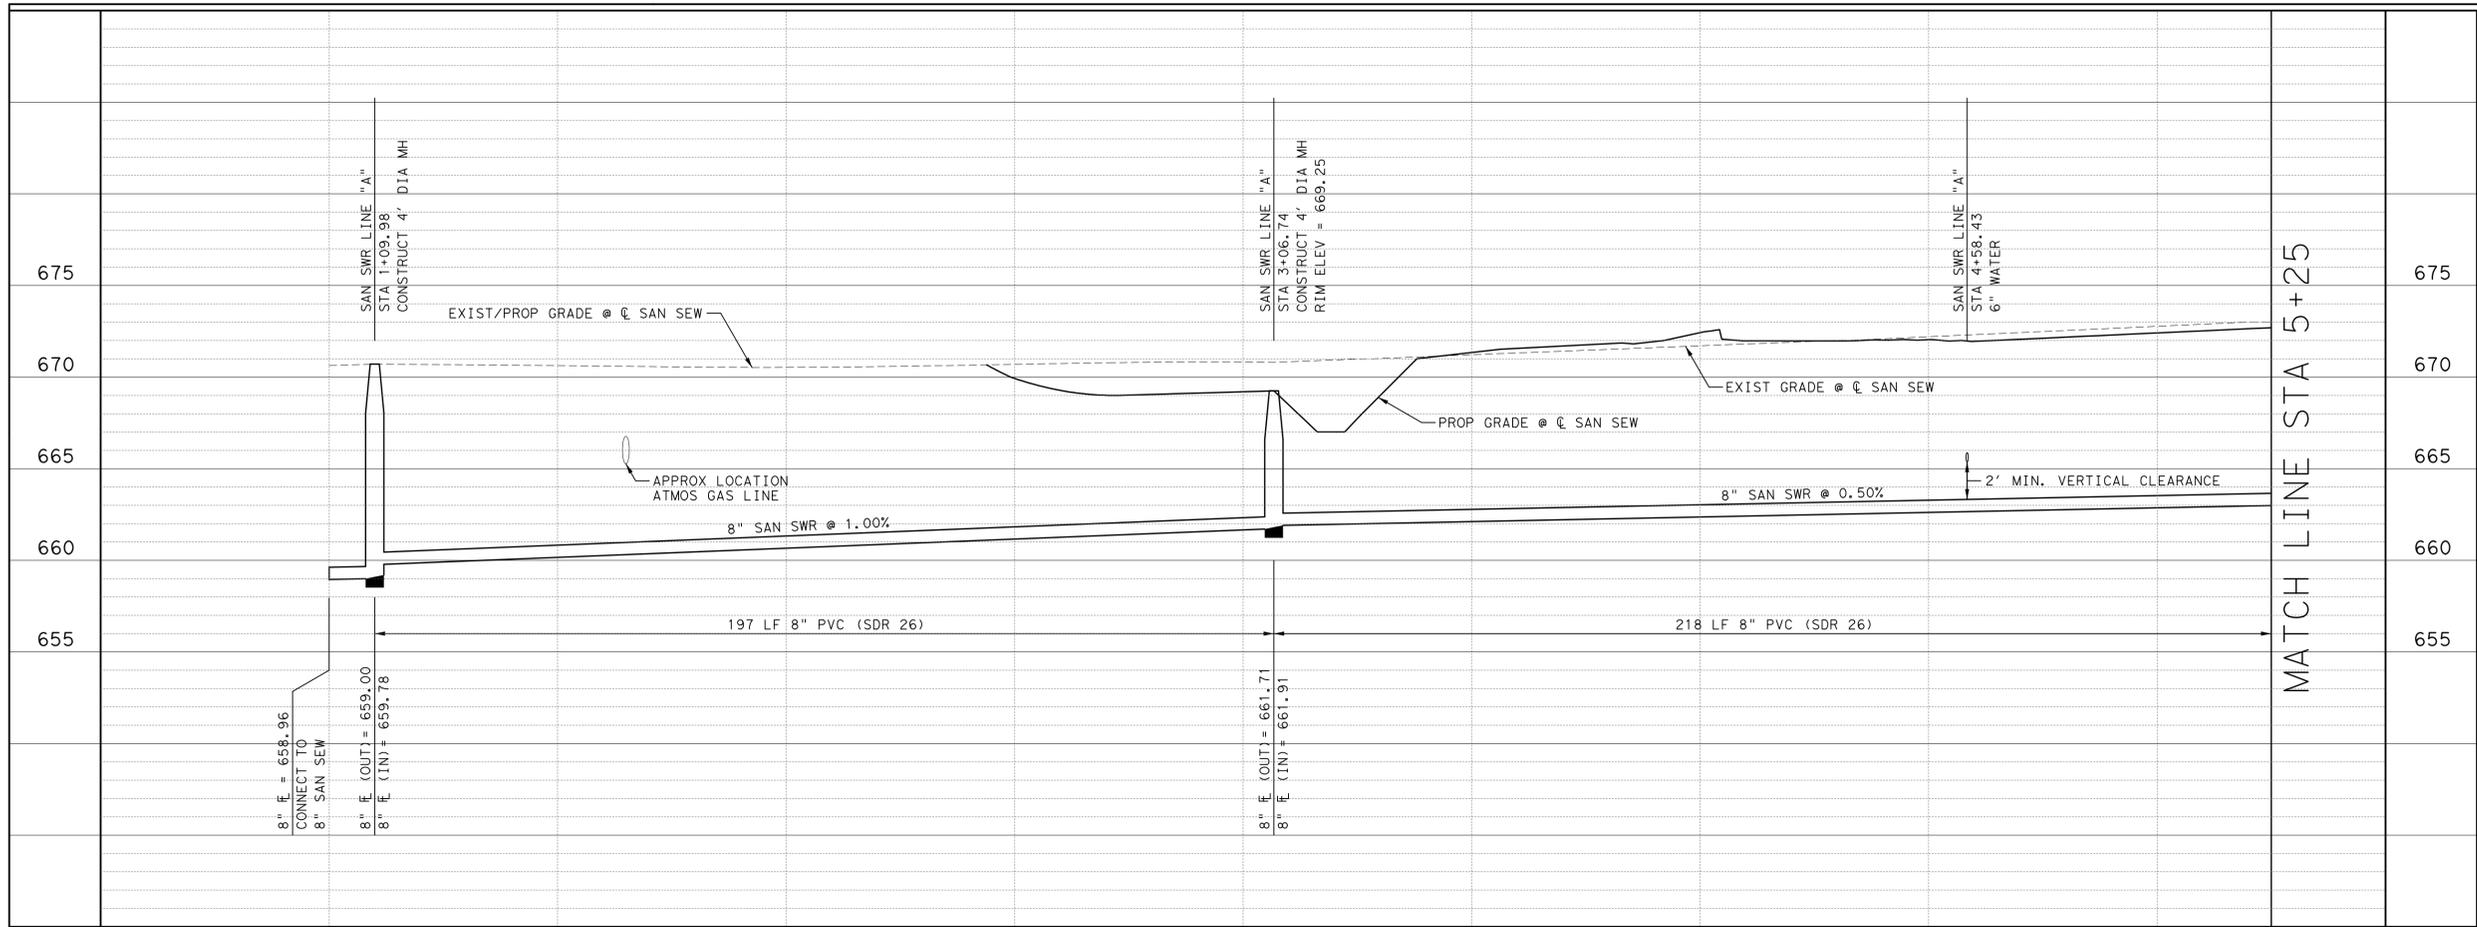

MATCH LINE STA 5+25

MATCH LINE STA 5+25

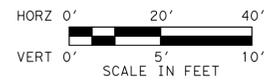

Trevor L. Castilla 8/24/15

NO.	REVISION	BY	DATE

CIVIL CONSULTING GROUP
 1515 HERITAGE DRIVE, STE. 212
 MCKINNEY, TEXAS 75069
 P 972.569.9193 F 972.569.9197
 TEXAS REGISTERED ENGINEERING FIRM NO. F-9356

**FIRST UNITED METHODIST CHURCH - CELINA
 LOT 1, BLOCK A
 FIRST UNITED METHODIST CHURCH ADDITION
 CITY OF CELINA, COLLIN COUNTY, TEXAS**

SANITARY SEWER PROFILE

DESIGNED- TLC	DRAWN- JRK	DATE- 8/24/2015
APPROVED- CCG	CHECKED- TLC	SCALE-

© = 9

F.M. 428

NADIM F. NIMEH FAMILY TRUST
DOCUMENT NO. 20110126000102110,
O.P.R.C.C.T.

LIMITS OF DISTURBED
AREA - 7.8 AC

10 LF EROSION
CONTROL LOG (TYP)

NOTES:
SEDIMENT CONTROL FENCE AND EROSION CONTROL LOG MAINTENANCE REQUIREMENTS
SILT FENCE SHOULD BE INSPECTED REGULARLY (AT LEAST AS OFTEN AS REQUIRED BY THE TPDES CONSTRUCTION GENERAL PERMIT, APPENDIX A) FOR BUILDUP OF EXCESS SEDIMENT, UNDERCUTTING, SAGS, AND OTHER FAILURES. SEDIMENT SHOULD BE REMOVED WHEN IT REACHES APPROXIMATELY ONE-HALF THE HEIGHT OF THE FENCE/LOG. IN ADDITION, DETERMINE THE SOURCE OF EXCESS SEDIMENT AND IMPLEMENT APPROPRIATE BMPs TO CONTROL THE EROSION. IF THE FABRIC BECOMES DAMAGED OR CLOGGED, IT SHOULD BE REPAIRED OR REPLACED AS NECESSARY.

CONSTRUCTION EXIT MAINTENANCE REQUIREMENTS
CONSTRUCTION ENTRANCES SHOULD BE INSPECTED REGULARLY (AT LEAST AS OFTEN AS REQUIRED BY THE TPDES CONSTRUCTION GENERAL PERMIT, APPENDIX A). WHEN SEDIMENT HAS SUBSTANTIALLY CLOGGED THE VOID AREA BETWEEN THE ROCKS, THE AGGREGATE MAT MUST BE WASHED DOWN OR REPLACED. PERIODIC RE-GRADING AND TOP DRESSING WITH ADDITIONAL STONE MUST BE DONE TO KEEP THE EFFICIENCY OF THE ENTRANCE FROM DIMINISHING.

IF THE STABILIZED CONSTRUCTION ENTRANCE IS NOT EFFECTIVELY REMOVING SEDIMENT FROM WHEELS THEN A WHEEL WASH SHOULD BE CONSIDERED.

MAINTENANCE AND INSPECTION PROCEDURES
CONTROL MEASURES WILL BE INSPECTED AT LEAST ONCE A WEEK OR WITHIN 24 HOURS OF ANY STORM EVENT OF 0.5 INCHES OR GREATER. IF A REPAIR IS NECESSARY IT WILL BE DONE AT THE EARLIEST PRACTICAL DATE BUT WITHIN 48 HOURS.
CONTRACTOR SHALL POLICE SITE REGULARLY AND KEEP SITE FREE OF TRASH AND CONSTRUCTION DEBRIS. CONTRACTOR IS REQUIRED TO REPAIR AND/OR REPLACE DAMAGED EROSION CONTROL DEVICES.

INSTALL 1500 SY
SLOPE PROTECTION
(CURLEX I CL)

DRAINAGE EASEMENT

40 LF EROSION
CONTROL LOG


10 LF EROSION
CONTROL LOG (TYP)

20 LF EROSION
CONTROL LOG

INSTALL CONSTRUCTION EXIT
(166 SY)

INSTALL 1160 LF
SEDIMENT CONTROL FENCE

LANDMARK/CELINA WEST, .L.P.
VOLI. 5505, PG. 3689,
D.R.C.C.T.

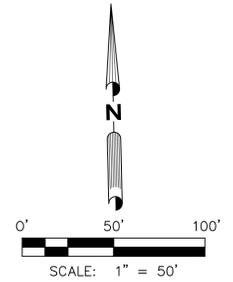

Professional Engineer seal for Trevor L. Castilla, No. 85405, State of Texas. Signature of Trevor L. Castilla dated 8/24/15.

NO.	REVISION	BY	DATE

CIVIL CONSULTING GROUP logo and address: 1515 HERITAGE DRIVE, STE. 212 MCKINNEY, TEXAS 75069 P 972.569.9193 F 972.569.9197 TEXAS REGISTERED ENGINEERING FIRM NO. F-9356

**FIRST UNITED METHODIST CHURCH - CELINA
LOT 1, BLOCK A
FIRST UNITED METHODIST CHURCH ADDITION
CITY OF CELINA, COLLIN COUNTY, TEXAS**






EROSION CONTROL PLAN

PROJECT NAME & LOCATION:	FIRST UNITED METHODIST CHURCH CAMPUS RELOCATION FM 428, 1500 LF S OF FM 455
OPERATOR NAME & ADDRESS:	FIRST UNITED METHODIST CHURCH-CELINA
DETAILED PROJECT DESCRIPTION:	PAVING, GRADING, AND UTILITIES
TOTAL PROJECT AREA:	19.789 AC
TOTAL AREA TO BE DISTURBED:	7.8 AC
ESTIMATED PROJECT START DATE:	MAY 2015
ESTIMATED PROJECT END DATE:	MARCH 2016
EROSION & SEDIMENT BMPs:	EROSION CONTROL LOGS, SILT FENCE, ESTABLISHED VEGETATION (SOD), PRESERVATION OF EXISTING VEGETATION, CONSTRUCTION ENTRANCE/EXIT
STABILIZATION PRACTICES:	ESTABLISHED VEGETATION, PAVING




DESIGNED- TLC	DRAWN- JRK	DATE- 8/24/2015	C-10
APPROVED- CCG	CHECKED- TLC	SCALE-	

P-201504-01

FILENAME: FLIMC*EROSTION.dgn
PLOTTED: 8/24/2015

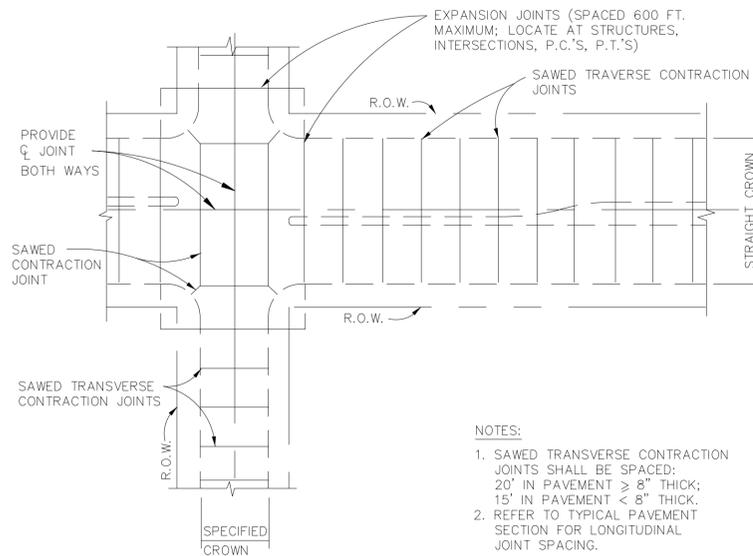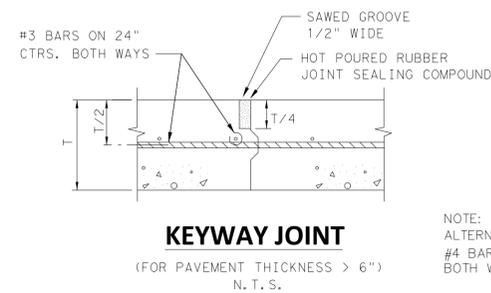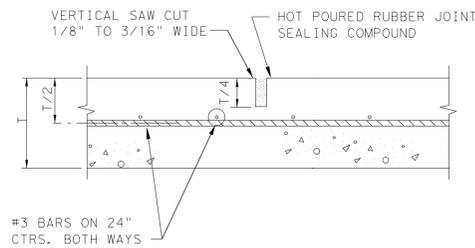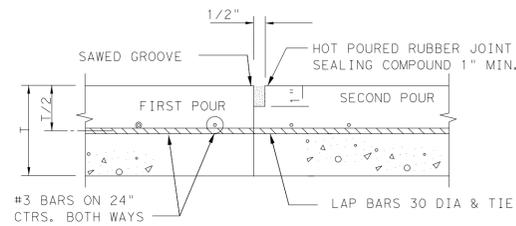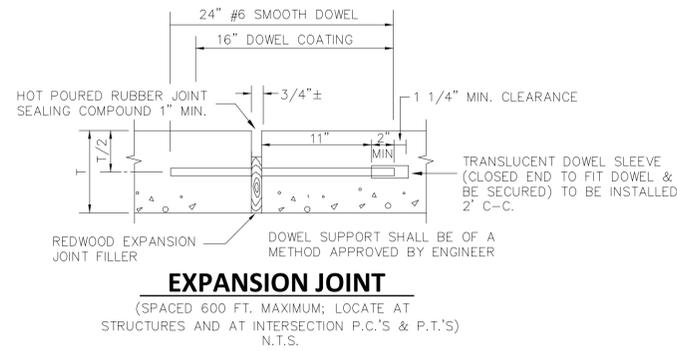

- NOTES:
1. SAWED TRANSVERSE CONTRACTION JOINTS SHALL BE SPACED:
20' IN PAVEMENT ≥ 8" THICK;
15' IN PAVEMENT < 8" THICK.
2. REFER TO TYPICAL PAVEMENT SECTION FOR LONGITUDINAL JOINT SPACING.

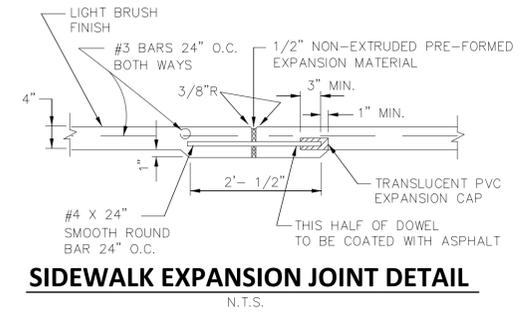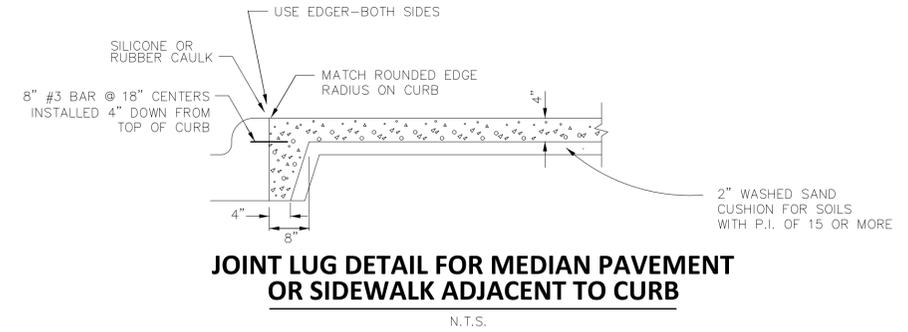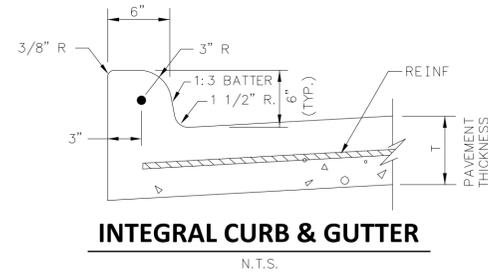

- NOTE:
1. REFER TO STANDARD SPECIFICATION ITEM 8.3. FOR ALTERNATE REINFORCEMENT.
2. CROSS SLOPE OF SIDEWALK SHALL BE ± 1/4" PER FT. MAX.
3. OTHER THAN 6'-0" SIDEWALK WIDTH MAY BE SPECIFIED BY OWNER.
4. SIDEWALK SHALL BE CLASS "A" CONCRETE UNLESS OTHERWISE SPECIFIED BY OWNER.
5. ALL HONEYCOMB IN BACK OF CURB TO BE TROWEL-PLASTERED BEFORE POURING SIDEWALK.
6. LUG MAY BE FORMED BY SHAPING SUBGRADE TO APPROXIMATE DIMENSIONS SHOWN.



Trevor L. Castilla 8/24/15

NO.	REVISION	BY	DATE


CIVIL CONSULTING GROUP
1515 HERITAGE DRIVE, STE. 212
MCKINNEY, TEXAS 75069
P 972.569.9193 F 972.569.9197
TEXAS REGISTERED ENGINEERING FIRM NO. F-9356

**FIRST UNITED METHODIST CHURCH - CELINA
LOT 1, BLOCK A
FIRST UNITED METHODIST CHURCH ADDITION
CITY OF CELINA, COLLIN COUNTY, TEXAS**


**MISCELLANEOUS DETAILS
PAVING**

DESIGNED- TLC	DRAWN- JRK	DATE- 8/24/2015	D-1
APPROVED- CCG	CHECKED- TLC	SCALE-	


DETENTION OUTLET STRUCTURE DETAILS

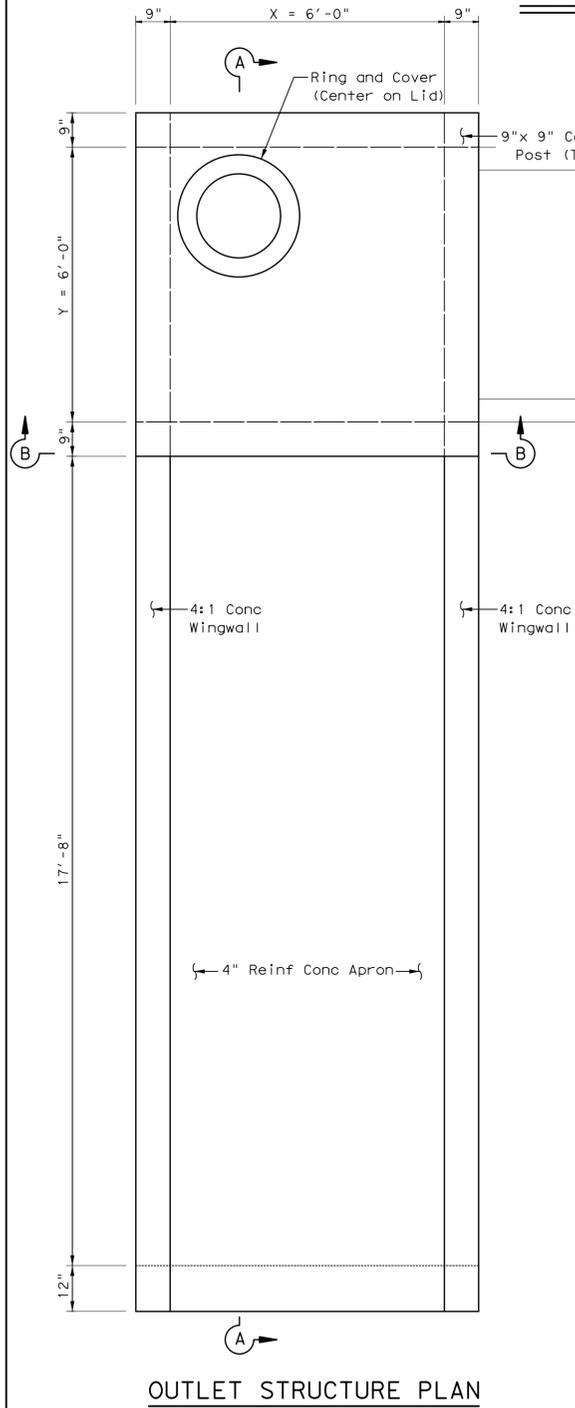


OUTLET STRUCTURE PLAN

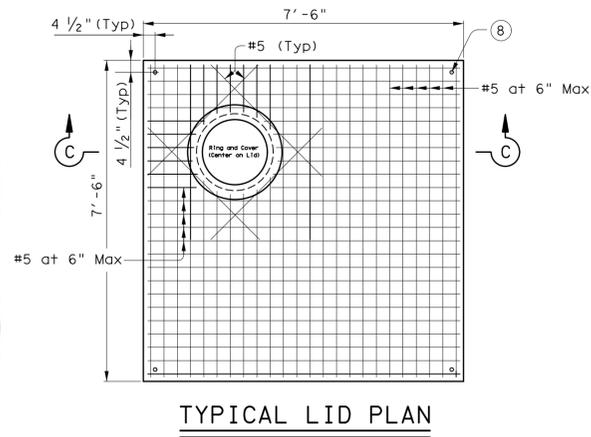


TYPICAL LID PLAN

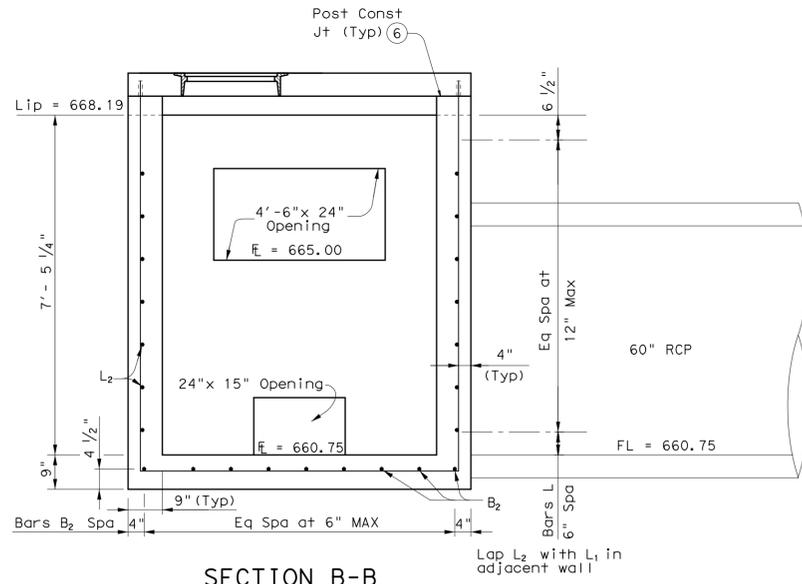

SECTION B-B

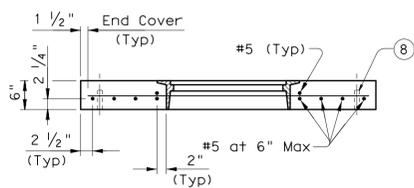

SECTION C-C

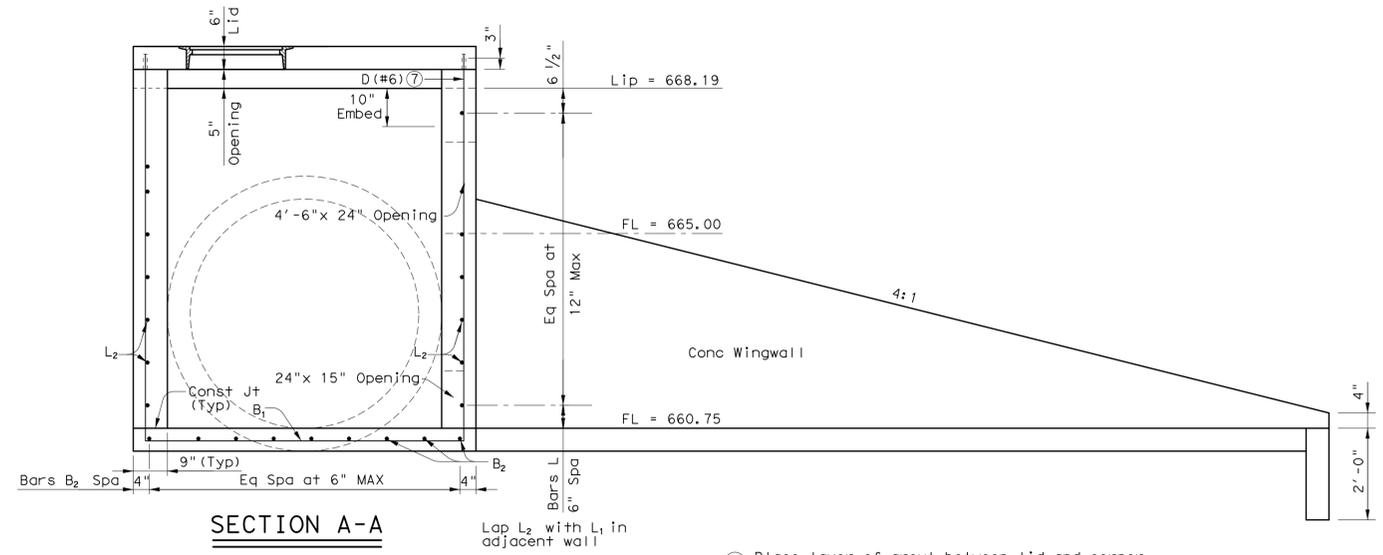

SECTION A-A

- ⑥ Place layer of grout between lid and corner posts to provide stable seating of lid.
- ⑦ Center Dowels D in corner posts. (Typ)
- ⑧ Form holes in lid for Dowels D using 1" Dia x 4" PVC Pipe (SCH 40) (Typ).

GENERAL NOTES:

When approved, precast inlets with equivalent structural capacity may be furnished. Sealed engineering calculations and drawings shall be submitted for approval prior to construction.

Lid will be precast.


In areas of conflict between reinforcing steel, blockouts, pipes, anchor bolts or other reinforcing steel, the reinforcement shall be bent or adjusted to clear as directed by the Engineer.

Structural steel for grates shall conform to the requirements of ASTM designation A-36 or AISI Designation M1010-M1020.

All reinforcing steel shall be Grade 60 unless otherwise noted.

All concrete shall be Class "A" ($f'c = 3,000$ psi).

All steel components except reinforcing, shall be galvanized after fabrication. Galvanizing damaged during transport or construction shall be repaired in accordance with the specifications.

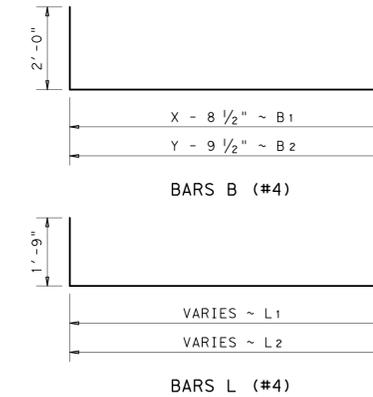

Trevor L. Castilla 8/24/15


NO.	REVISION	BY	DATE

1515 HERITAGE DRIVE, STE. 212
 MCKINNEY, TEXAS 75069
 P 972.569.9193 F 972.569.9197
 TEXAS REGISTERED ENGINEERING FIRM NO. F-9356


FIRST UNITED METHODIST CHURCH - CELINA
LOT 1, BLOCK A
FIRST UNITED METHODIST CHURCH ADDITION
CITY OF CELINA, COLLIN COUNTY, TEXAS

MISCELLANEOUS DETAILS
DRAINAGE

DESIGNED- TLC	DRAWN- JRK	DATE- 8/24/2015	D - 2
APPROVED- CCG	CHECKED- TLC	SCALE-	

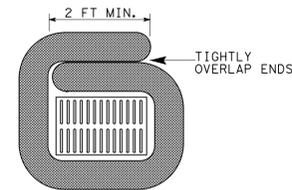

DROP INLET
USE 12" DIAMETER LOG
INLET PROTECTION

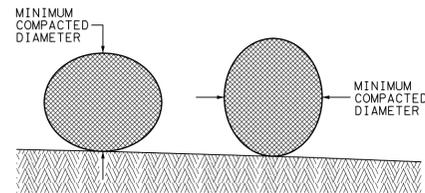


DIAMETER MEASUREMENTS OF EROSION CONTROL LOGS SPECIFIED IN PLANS

MATERIAL REQUIREMENTS

FILL:
USE 100% SHREDDED MULCH OR OTHER NON-COMPOST BIODEGRADABLE MATERIAL AS FILL FOR LOGS. NO COMPOST OR FINES.
DO NOT USE MATERIAL WHICH PROHIBITS WATER INFILTRATION.


LOG MESH:
USE MESH WITH 1#4" OPENINGS OR LARGER. MESH MUST ALLOW WATER INFILTRATION BUT ALSO HOLD FILL MATERIAL IN PLACE.

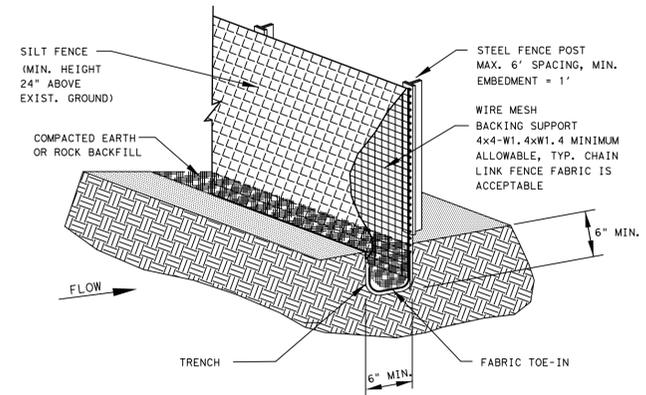


SILT FENCE

SILT FENCE GENERAL NOTES:

1. STEEL POSTS WHICH SUPPORT THE SILT FENCE SHALL BE INSTALLED ON A SLIGHT ANGLE TOWARD THE ANTICIPATED RUNOFF SOURCE. POST MUST BE EMBEDDED A MINIMUM OF ONE FOOT.
2. THE TOE OF THE SILT FENCE SHALL BE TRENCHED IN WITH A SPADE OR MECHANICAL TRENCHER, SO THAT THE DOWNSLOPE FACE OF THE TRENCH IS FLAT AND PERPENDICULAR TO THE LINE OF FLOW. WHERE FENCE CANNOT BE TRENCHED IN (e.g. PAVEMENT), WEIGHT FABRIC FLAP WITH ROCK ON UPHILL SIDE TO PREVENT FLOW FROM SEEPING UNDER FENCE.
3. THE TRENCH MUST BE A MINIMUM OF 6 INCHES DEEP AND 6 INCHES WIDE TO ALLOW FOR THE SILT FENCE FABRIC TO BE LAID IN THE GROUND AND BACKFILLED WITH COMPACTED MATERIAL.
4. SILT FENCE SHOULD BE SECURELY FASTENED TO EACH STEEL SUPPORT POST OR TO WOVEN WIRE, WHICH IN TURN IS ATTACHED TO THE STEEL FENCE POST. THERE SHALL BE A 3 FOOT OVERLAP, SECURELY FASTENED WHERE ENDS OF FABRIC MEET.
5. INSPECTION SHALL BE MADE EVERY TWO WEEKS AND AFTER EACH 1/2" RAINFALL. REPAIR OR REPLACEMENT SHALL BE MADE PROMPTLY AS NEEDED.
6. SILT FENCE SHALL BE REMOVED WHEN THE SITE IS COMPLETELY STABILIZED SO AS NOT TO BLOCK OR IMPEDE STORM FLOW OR DRAINAGE.
7. ACCUMULATED SILT SHALL BE REMOVED WHEN IT REACHES A DEPTH OF HALF THE HEIGHT OF THE FENCE. THE SILT SHALL BE DISPOSED OF AT AN APPROVED SITE AND IN SUCH A MANNER AS TO NOT CONTRIBUTE TO ADDITIONAL SILTATION.

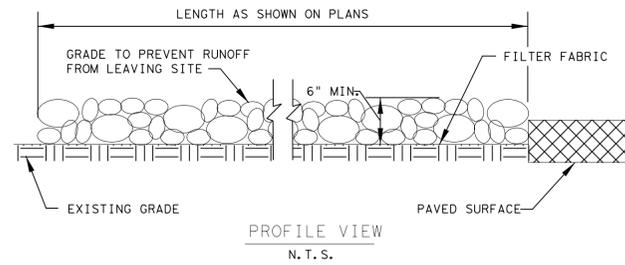

PROFILE VIEW
N. T. S.

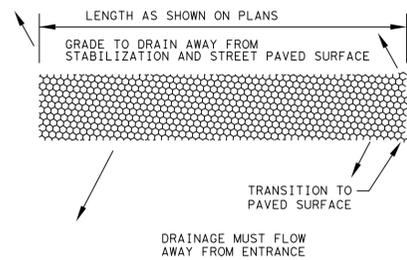

PLAN VIEW
N. T. S.

STABILIZED CONSTRUCTION ENTRANCE

STABILIZED CONSTRUCTION ENTRANCE GENERAL NOTES:

1. STONE SHALL BE 3 TO 5 INCH DIAMETER CRUSHED ROCK OR ACCEPTABLE CRUSHED PORTLAND CEMENT CONCRETE.
2. LENGTH SHALL BE SHOWN ON PLANS, WITH A MINIMUM LENGTH OF 30 FEET FOR LOTS WHICH ARE LESS THAN 150 FEET FROM EDGE OF PAVEMENT. THE MINIMUM DEPTH IN ALL OTHER CASES SHALL BE 50 FEET.
3. THE THICKNESS SHALL NOT BE LESS THAN 6 INCHES.
4. THE WIDTH SHALL BE NO LESS THAN THE FULL WIDTH OF ALL POINTS OF INGRESS OR EGRESS.
5. WHEN NECESSARY, VEHICLES SHALL BE CLEANED TO REMOVE SEDIMENT PRIOR TO ENTRANCE ONTO A PUBLIC ROADWAY. WHEN WASHING IS REQUIRED, IT SHALL BE DONE ON AN AREA STABILIZED WITH CRUSHED STONE WITH DRAINAGE FLOWING AWAY FROM BOTH THE STREET AND THE STABILIZED ENTRANCE. ALL SEDIMENT SHALL BE PREVENTED FROM ENTERING ANY STORM DRAIN, DITCH OR WATERCOURSE USING APPROVED METHODS.
6. THE ENTRANCE SHALL BE MAINTAINED IN A CONDITION WHICH WILL PREVENT TRACKING OR FLOWING OF SEDIMENT ONTO PAVED SURFACES. THIS MAY REQUIRE PERIODIC TOP DRESSING WITH ADDITIONAL STONE AS CONDITIONS DEMAND. ALL SEDIMENT SPILLED, DROPPED, WASHED, OR TRACKED ONTO PAVED SURFACES MUST BE REMOVED IMMEDIATELY.
7. THE ENTRANCE MUST BE PROPERLY GRADED OR INCORPORATE A DRAINAGE SWALE TO PREVENT RUNOFF FROM LEAVING THE CONSTRUCTION SITE.

STATE OF TEXAS
TREVOR L. CASTILLA
85405
PROFESSIONAL ENGINEER
Trevor L. Castilla 8/24/15


NO.	REVISION	BY	DATE

CIVIL CONSULTING GROUP
1515 HERITAGE DRIVE, STE. 212
MCKINNEY, TEXAS 75069
P 972.569.9193 F 972.569.9197
TEXAS REGISTERED ENGINEERING FIRM NO. F-9356

FIRST UNITED METHODIST CHURCH - CELINA
LOT 1, BLOCK A
FIRST UNITED METHODIST CHURCH ADDITION
CITY OF CELINA, COLLIN COUNTY, TEXAS


MISCELLANEOUS DETAILS
EROSION CONTROL

DESIGNED- TLC	DRAWN- JRK	DATE- 8/24/2015	D - 5
APPROVED- CCG	CHECKED- TLC	SCALE-	

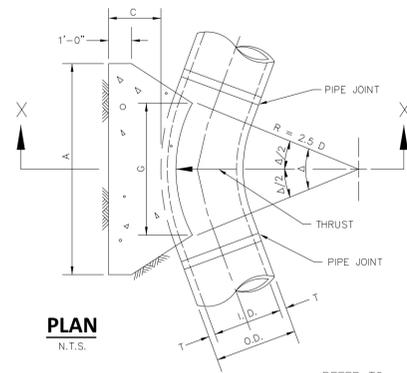


PLAN
N.T.S.

REFER TO
STD. DWG. No. 4040
FOR GENERAL NOTES.

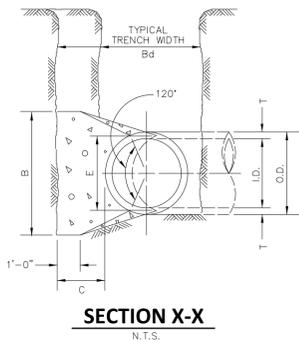

SECTION X-X
N.T.S.

**HORIZONTAL THRUST BLOCK
AT PIPE BEND**

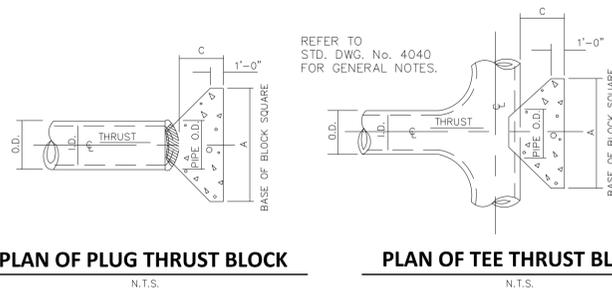

PLAN OF PLUG THRUST BLOCK
N.T.S.

PLAN OF TEE THRUST BLOCK
N.T.S.

REFER TO
STD. DWG. No. 4040
FOR GENERAL NOTES.


**HORIZONTAL THRUST BLOCK
AT TEES AND PLUGS**

I.D. (IN.)	THRUST (TONS)	EARTH			ROCK		
		A (FT.)	B (FT.)	VOL. (C.Y.)	A (FT.)	B (FT.)	VOL. (C.Y.)
4,6,8	0.4	1.0	1.5	0.1	1.0	1.5	0.1
10,12	1.5	5.9	2.5	0.3	2.0	1.5	0.2
16,18	2.2	13.2	3.5	0.4	2.5	3.0	0.4
20	2.4	16.3	4.5	0.4	3.0	3.0	0.5
24	2.9	23.4	6.0	0.4	3.5	3.5	0.7
30	3.6	27.5	6.5	0.5	4.0	3.0	0.9
36	4.4	39.5	7.0	0.6	4.5	4.5	1.6
42	5.1	53.8	8.0	0.7	5.1	5.5	2.5
48	5.8	70.3	9.0	0.8	6.0	6.0	3.7
54	6.5	89.0	10.0	0.9	7.0	6.5	5.3
60	7.3	110.0	11.0	1.0	8.0	7.5	7.3
66	8.0	132.9	12.5	1.1	9.0	8.5	9.6
72	8.7	158.2	13.5	1.2	10.0	9.0	12.3
78	9.4	185.6	14.5	1.3	11.0	9.5	15.6
84	10.1	215.3	15.5	1.4	12.0	10.5	19.5
90	10.9	247.1	16.5	1.5	13.0	11.5	23.9
96	11.6	281.2	18.0	1.6	14.0	12.5	28.9

I.D. (IN.)	T (N.)	Δ = 11.25°		Δ = 22.50°		E (FT.)
		A (FT.)	B (FT.)	A (FT.)	B (FT.)	
4,6,8	0.4	1.5	1.5	1.5	0.9	
10,12	1.5	1.5	1.5	1.5	1.2	
16,18	0.6	1.5	1.5	1.5	1.6	
20	0.7	1.5	1.5	1.5	1.8	
24	0.9	1.5	1.5	1.5	2.1	
30	2.9	1.5	1.9	2.6		
36	4.5	1.5	2.3	3.3		
42	5.0	1.8	2.6	3.8		
48	5.5	2.0	3.0	4.3		
54	6.0	2.3	3.4	4.8		
60	6.5	2.5	3.8	5.3		
66	6.8	2.8	4.1	5.7		
72	7.5	3.0	4.5	6.3		
78	7.5	3.3	4.9	6.7		
84	8.0	3.5	5.3	7.2		
90	8.5	3.8	5.6	7.7		
96	9.0	4.0	6.0	8.2		

I.D. (IN.)	G (FT.)	THRUST (TONS)	EARTH			ROCK			I.D. (IN.)	G (FT.)	THRUST (TONS)	EARTH			ROCK		
			A (FT.)	B (FT.)	VOL. (C.Y.)	A (FT.)	B (FT.)	VOL. (C.Y.)				A (FT.)	B (FT.)	VOL. (C.Y.)	A (FT.)	B (FT.)	VOL. (C.Y.)
4,6,8	0.4	1.0	1.0	1.5	0.1	1.0	1.0	0.1	4,6,8	0.8	2.0	1.5	1.5	0.1	1.0	1.0	0.1
10,12	0.6	2.2	1.5	1.5	0.1	1.0	1.5	0.1	10,12	1.1	4.4	2.0	2.5	0.3	1.5	1.5	0.1
16,18	0.8	5.0	2.0	2.5	0.3	1.5	2.0	0.2	16,18	1.6	9.9	3.0	3.5	0.6	2.0	2.5	0.3
20	0.9	6.2	2.0	3.5	0.4	1.5	3.0	0.3	20	1.8	12.3	3.5	3.5	0.7	2.0	3.0	0.4
24	1.1	8.9	3.0	3.5	0.5	1.5	3.0	0.3	24	2.2	17.7	4.0	4.5	1.0	3.0	3.5	0.5
30	1.4	10.4	3.0	3.5	0.6	2.0	3.5	0.4	30	2.7	20.7	5.0	4.5	1.5	3.0	4.0	0.8
36	1.7	15.0	3.5	4.5	0.9	2.0	4.0	0.5	36	3.3	29.8	5.5	5.5	2.3	4.0	4.0	1.3
42	1.9	20.4	4.5	5.0	1.5	2.5	5.0	0.8	42	3.8	40.5	7.0	6.0	3.9	4.5	5.0	2.1
48	2.2	26.6	4.5	6.0	2.0	2.5	6.0	1.1	48	4.4	52.9	8.0	7.0	5.7	4.5	6.0	2.8
54	2.5	33.7	6.0	6.0	3.0	3.0	6.0	1.4	54	4.9	67.0	9.0	8.0	8.0	6.0	6.0	4.1
60	2.7	41.6	6.0	7.0	3.8	3.0	7.0	1.8	60	5.5	82.7	9.5	9.0	10.6	6.0	7.0	5.3
66	3.0	50.3	6.5	8.0	5.1	3.5	8.0	2.7	66	6.0	100.1	10.5	10.0	14.1	6.5	8.0	7.2
72	3.3	59.9	7.5	8.0	6.3	4.0	8.0	3.3	72	6.6	119.1	11.0	11.0	17.6	7.5	8.0	9.1
78	3.6	70.2	8.0	9.0	8.1	4.0	9.0	3.9	78	7.1	139.8	12.0	12.0	22.5	8.0	9.0	11.7
84	3.8	81.5	8.5	10.0	10.3	4.5	10.0	5.3	84	7.6	162.1	13.0	12.5	27.2	8.5	10.0	14.8
90	4.1	93.5	9.5	10.0	12.2	5.0	10.0	6.3	90	8.2	186.1	14.0	13.5	33.7	9.5	10.0	17.7
96	4.4	106.4	10.0	11.0	15.0	5.0	11.0	7.4	96	8.7	211.7	15.0	14.5	41.2	10.0	11.0	21.8

TABLES OF DIMENSIONS AND QUANTITIES

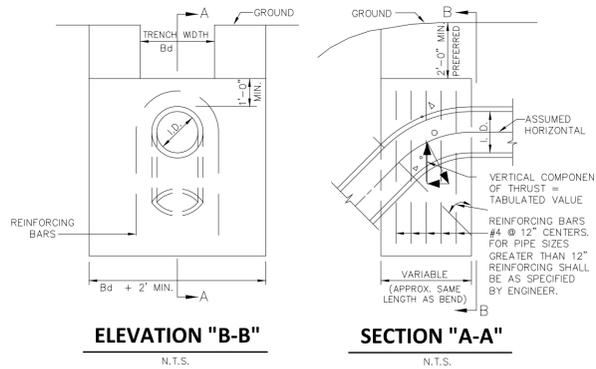

ELEVATION "B-B"
N.T.S.


SECTION "A-A"
N.T.S.

I.D. (IN.)	THRUST (TONS)	11.25°			22.50°			30°			45°			67.50°			90°			
		A (FT.)	B (FT.)	VOL. (C.Y.)																
4,6,8	1.0	0.5	2.0	1.0	2.5	1.3	3.6	1.8	4.6	2.3	5.0	2.5	4,6,8							
10,12	2.2	1.1	4.3	2.2	5.7	2.8	8.0	4.0	10.5	5.2	11.3	5.7	10,12							
16,18	5.0	2.5	9.7	4.9	12.7	6.4	18.0	9.0	23.5	11.8	25.5	12.7	16,18							
20	6.1	3.1	12.0	6.0	15.7	7.9	22.2	11.1	29.2	14.5	31.4	15.7	20							
24	8.2	4.4	17.3	8.7	22.6	11.3	32.0	16.0	41.8	20.9	45.2	22.6	24							
30	10.5	5.2	20.3	10.1	26.5	13.3	37.5	18.8	49.0	24.5	53.1	26.5	30							
36	14.9	7.5	29.2	14.6	38.2	19.1	54.0	27.0	70.5	35.3	76.4	38.2	36							
42	20.3	10.1	39.8	19.9	52.0	26.0	73.5	36.7	96.0	48.0	104.0	52.0	42							
48	26.5	13.2	51.9	26.0	67.9	33.9	96.0	48.0	126.0	62.7	136.0	67.9	48							
54	33.5	16.8	65.7	32.9	85.9	42.9	122.0	60.7	159.0	79.4	172.0	85.9	54							
60	41.4	20.7	81.2	40.6	106.0	53.0	150.0	75.0	196.0	98.0	212.0	106.0	60							
66	50.1	25.0	98.2	49.1	128.0	64.2	182.0	90.7	237.0	119.0	257.0	128.0	66							
72	59.6	29.8	117.0	58.4	153.0	76.3	216.0	108.0	282.0	141.0	305.0	153.0	72							
78	69.9	35.0	137.0	68.6	179.0	90.0	254.0	127.0	331.0	166.0	358.0	179.0	78							
84	81.1	40.5	159.0	79.5	208.0	104.0	294.0	147.0	384.0	192.0	416.0	208.0	84							
90	93.1	46.5	183.0	91.3	239.0	119.0	337.0	169.0	441.0	221.0	477.0	239.0	90							
96	106.0	53.0	208.0	104.0	272.0	136.0	384.0	192.0	502.0	251.0	543.0	272.0	96							

**VERTICAL THRUST BLOCK
AT PIPE BEND**

I.D. (IN.)	G (FT.)	THRUST (TONS)	EARTH			ROCK			I.D. (IN.)	G (FT.)	THRUST (TONS)	EARTH			ROCK		
			A (FT.)	B (FT.)	VOL. (C.Y.)	A (FT.)	B (FT.)	VOL. (C.Y.)				A (FT.)	B (FT.)	VOL. (C.Y.)	A (FT.)	B (FT.)	VOL. (C.Y.)
4,6,8	1.0	2.6	2.0	1.5	0.2	1.0	1.5	0.1	4,6,8	1.5	3.9	2.0	2.0	0.2	1.5	1.5	0.1
10,12	1.5	5.9	2.5	2.5	0.3	2.0	1.5	0.2	10,12	2.2	8.7	3.5	2.5	0.5	2.0	2.5	0.3
16,18	2.2	13.2	3.5	4.0	0.8	2.5	3.0	0.4	16,18	3.2	19.5	4.5	4.5	1.2	3.0	3.5	0.6
20	2.4	16.3	4.5	4.0	1.0	3.0	3.0	0.5	20	3.6	24.1	5.5	4.5	1.5	3.5	3.5	0.7
24	2.9	23.4	6.0	4.0	1.4	3.5	3.5	0.7	24	4.3	34.6	8.0	4.5	2.3	4.5	4.0	1.1
30	3.6	27.5	6.5	5.0	1.9	3.5	4.0	0.9	30	5.4	40.6	8.5	5.0	3.2	5.5	4.0	1.6
36	4.4	39.5	7.0	6.0	3.4	4.5	4.5	1.6	36	6.5	58.5	10.0	6.0	5.3	6.5	4.5	2.6
42	5.1	53.8	8.0	7.0	5.1	5.5	5.0	2.5	42	7.5	79.6	11.5	7.0	8.1	8.0	5.0	4.2
48	5.8	70.3	9.0	8.0	7.4	6.0	6.0	3.7	48	8.6	104.0	13.0	8.0	11.9	9.0	6.0	6.3
54	6.5	89.0	10.0	9.0	10.3	7.0	6.5	5.3	54	9.7	131.5	15.0	9.0	17.1	10.5	6.5	8.9
60	7.3	110.0	11.0	10.0	13.9	7.5	7.5	7.3	60	10.7	162.4	16.5	10.0	23.1	11.0	7.5	12.0
66	8.0	132.9	12.5	11.0	18.9	8.5	8.0	9.6	66	11.8	196.5	18.0	11.0	30.1	12.0	8.5	16.2
72	8.7	158.2	13.5	12.0	24.0	9.0	9.0	12.3	72	12.9	233.9	19.5	12.0	38.6	14.0	8.5	20.7
78	9.4	185.6	14.5	13.0	30.0	10.0	9.5	15.6	78	13.9	274.5	21.5	13.0	49.8	14.5	9.5	25.9
84	10.1</																


DISCLAIMER: The use of this standard is governed by the "Texas Engineering Practice Act". No warranty of any kind is made by TxDOT for any purpose whatsoever. TxDOT assumes no responsibility for the conversion of this standard to other formats or for incorrect results or damages resulting from its use.

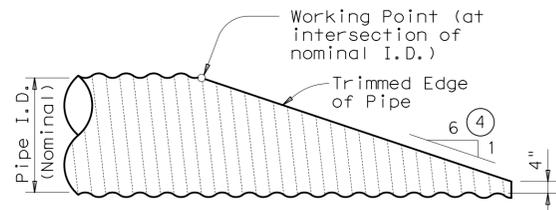


NOTE: All Cross Pipes, calculations, and dimensions are based on the pipe culverts mitered as shown in this detail. Alternate styles of mitered ends will require that appropriate adjustments be made to the values presented on this standard.

SIDE ELEVATION OF TYPICAL PIPE CULVERT MITER

(Showing Corrugated Metal Pipe Culvert.)
(Details at Concrete Pipe Culvert are similar.)


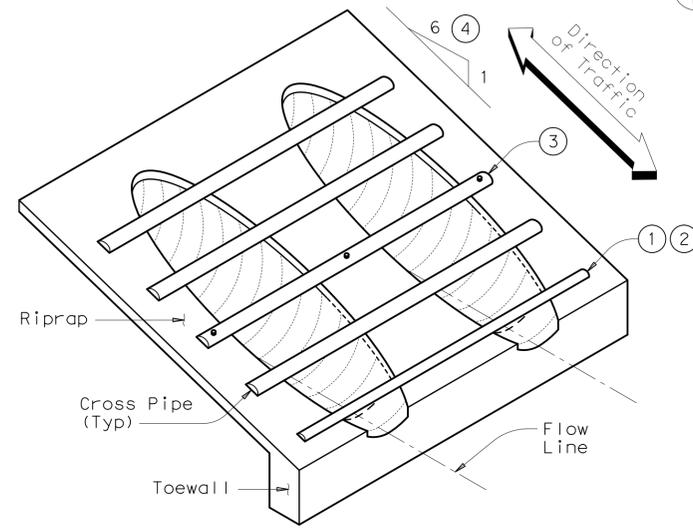


ISOMETRIC VIEW OF TYPICAL INSTALLATION

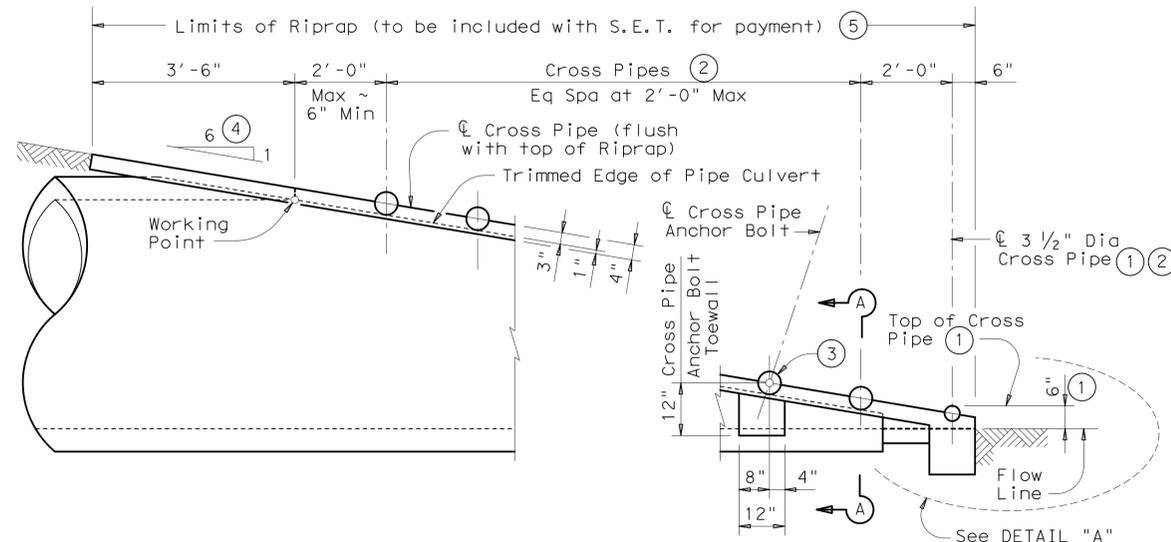


SIDE ELEVATION OF CAST-IN-PLACE CONCRETE


(Showing Concrete Pipe Culvert.)
(Details at Corrugated Metal Pipe Culvert are similar.)

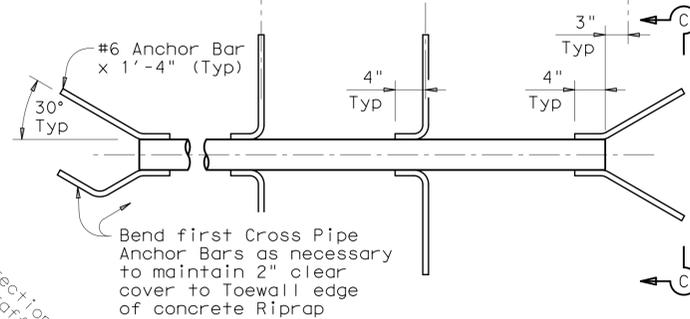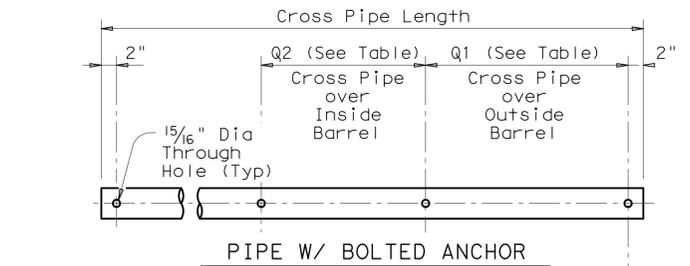

PIPE W/ ANCHOR BARS

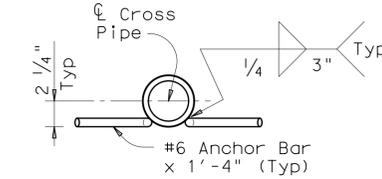


CROSS PIPE DETAILS

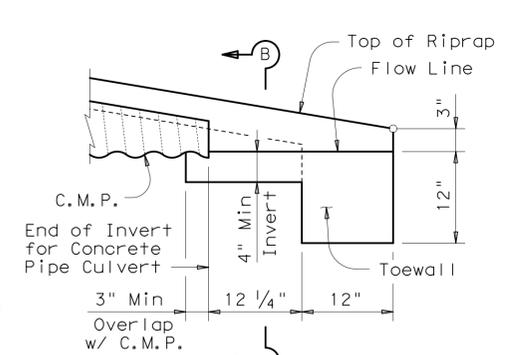


DETAIL "A"

(Showing Invert with Corrugated Metal Pipe Culvert. Concrete Pipe Culvert details are similar. Cross Pipes not shown for clarity.)

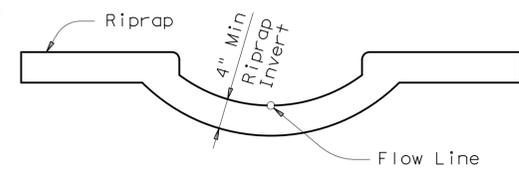


SECTION B-B

(Cross Pipes not shown for clarity.)

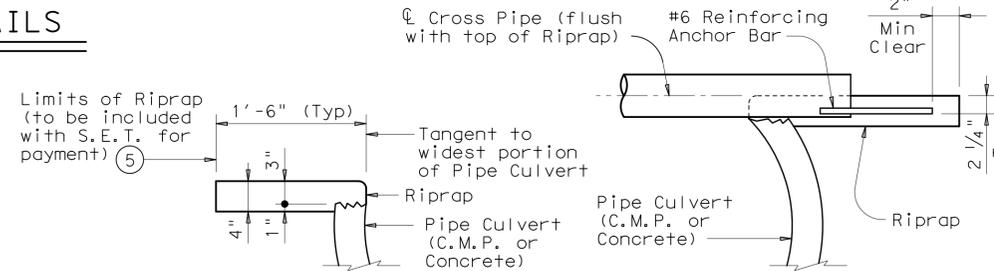

SHOWING TYPICAL PIPE CULVERT & RIPRAP

SHOWING CROSS PIPE WITH ANCHOR BAR

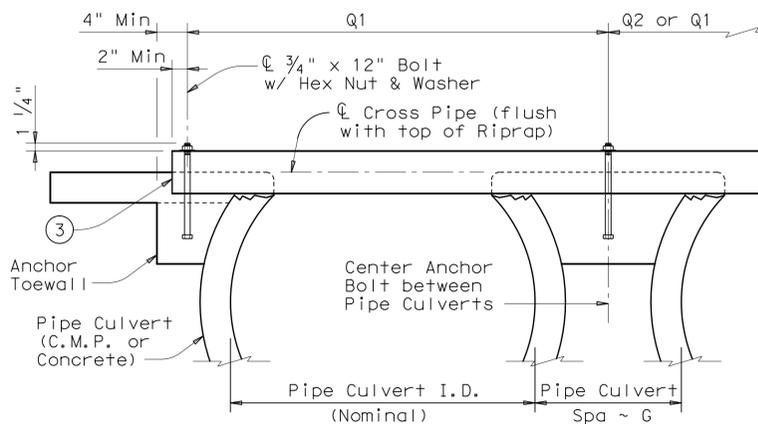

SECTION A-A

Nominal Culvert I.D.	Conc Riprap (CY) ⑥	Pipe Culvert Spa ~ G	Single Barrel ~ Q1	Multi-Barrel ~ Q1	Q2	Conditions for use of Cross Pipes	Cross Pipe Size
12"	0.6	9"	N/A	2'-1"	1'-9"	3 or more Pipe Culverts	3" Std (3,500" O.D.)
15"	0.7	11"	N/A	2'-5"	2'-2"		
18"	0.8	1'-2"	N/A	2'-10"	2'-8"		
21"	0.9	1'-4"	N/A	3'-2"	3'-1"		
24"	0.9	1'-7"	N/A	3'-6"	3'-7"	3 or more Pipe Culverts	3 1/2" Std (4,000" O.D.)
27"	1.0	1'-8"	N/A	3'-10"	3'-11"		
30"	1.1	1'-10"	N/A	4'-2"	4'-4"	2 or more Pipe Culverts	3 1/2" Std (4,000" O.D.)
33"	1.2	1'-11"	4'-2"	4'-5"	4'-8"	All Pipe Culverts	
36"	1.3	2'-1"	4'-5"	4'-9"	5'-1"	All Pipe Culverts	4" Std (4,500" O.D.)
42"	1.5	2'-4"	4'-11"	5'-5"	5'-10"		
48"	1.7	2'-7"	5'-5"	6'-0"	6'-7"	All Pipe Culverts	5" Std (5,563" O.D.)
54"	2.0	3'-0"	5'-11"	6'-9"	7'-6"		
60"	2.2	3'-3"	6'-5"	7'-4"	8'-3"		
66"	2.4	3'-3"	6'-11"	7'-10"	8'-9"		
72"	2.7	3'-4"	7'-5"	8'-5"	9'-4"		

- ① The proper installation of the first Cross Pipe is critical for vehicle safety. The top of the first Cross Pipe must be placed at no more than 6" above the flow line.
- ② Size of Cross Pipes, except the first bottom pipe, shall be as shown in the PIPE SIZE table. The first bottom pipe shall be 3 1/2" Standard Pipe (4" O.D.).
- ③ The third Cross Pipe from the bottom of the Culvert shall always be installed using a bolted connection. Care shall be taken to ensure that Riprap concrete does not flow into the Cross Pipe so as to permit disassembly of the bolted connection to allow cleanout access. At the Contractor's option, all other Cross Pipes may also be installed using the bolted connection details.
- ④ Match Cross Slope as shown elsewhere in the plans. Cross Slope of 6:1 or flatter is required for vehicle safety.
- ⑤ Riprap placed beyond the limits shown will be paid as Concrete Riprap in accordance with Item 432, "Riprap".
- ⑥ Quantities shown are for one end of one reinforced Concrete Pipe Culvert. For multiple pipe culverts or for Corrugated Metal Pipe Culverts, quantities will need to be adjusted. Riprap quantities are for Contractor's information only.

GENERAL NOTES:
 Cross Pipes are designed for a traversing load of 10,000 pounds at yield as recommended by Research Report 280-2F, "Safety Treatment of Roadside Parallel-Drainage Structures", Texas Transportation Institute, March 1981.
 Safety End Treatments shown herein are intended for use in those installations where out of control vehicles are likely to traverse the openings approximately perpendicular to the Cross Pipes.
 Riprap and all necessary inverts shall be Concrete Riprap conforming to the requirements of Item 432, "Riprap".
 Synthetic fibers listed on the "Fibers for Concrete" Material Producer List (MPL) may be used in lieu of steel reinforcing in riprap concrete unless noted otherwise.
 Payment for riprap and toewall is included in the Price Bid for each Safety End Treatment.
 Cross Pipes shall conform to the requirements of ASTM A53 (Type E or S, Grade B), ASTM A500 (Grade B), or API 5LX52. Bolts and nuts shall conform to ASTM A307.
 All steel components, except concrete reinforcing, shall be galvanized after fabrication. Galvanizing damaged during transport or construction shall be repaired in accordance with the specifications.

Bridge Division Standard

SAFETY END TREATMENT




FOR 12" DIA TO 72" DIA
PIPE CULVERTS
TYPE II ~ PARALLEL DRAINAGE

SETP-PD

FILE: setppdse.dgn	DN: GAF	CK: CAT	DW: JRP	CK: GAF
©TxDOT February 2010	CONT	SECT	JOB	HIGHWAY
REVISIONS				
11-10: Add note for synthetic fibers.	DIST	COUNTY	SHEET NO. D-8	

DISCLAIMER: The use of this standard is governed by the "Texas Engineering Practice Act". No warranty of any kind is made by TxDOT for any purpose whatsoever. TxDOT assumes no responsibility for the conversion of this standard to other formats or for incorrect results or damages resulting from its use.

DATE: FILE:

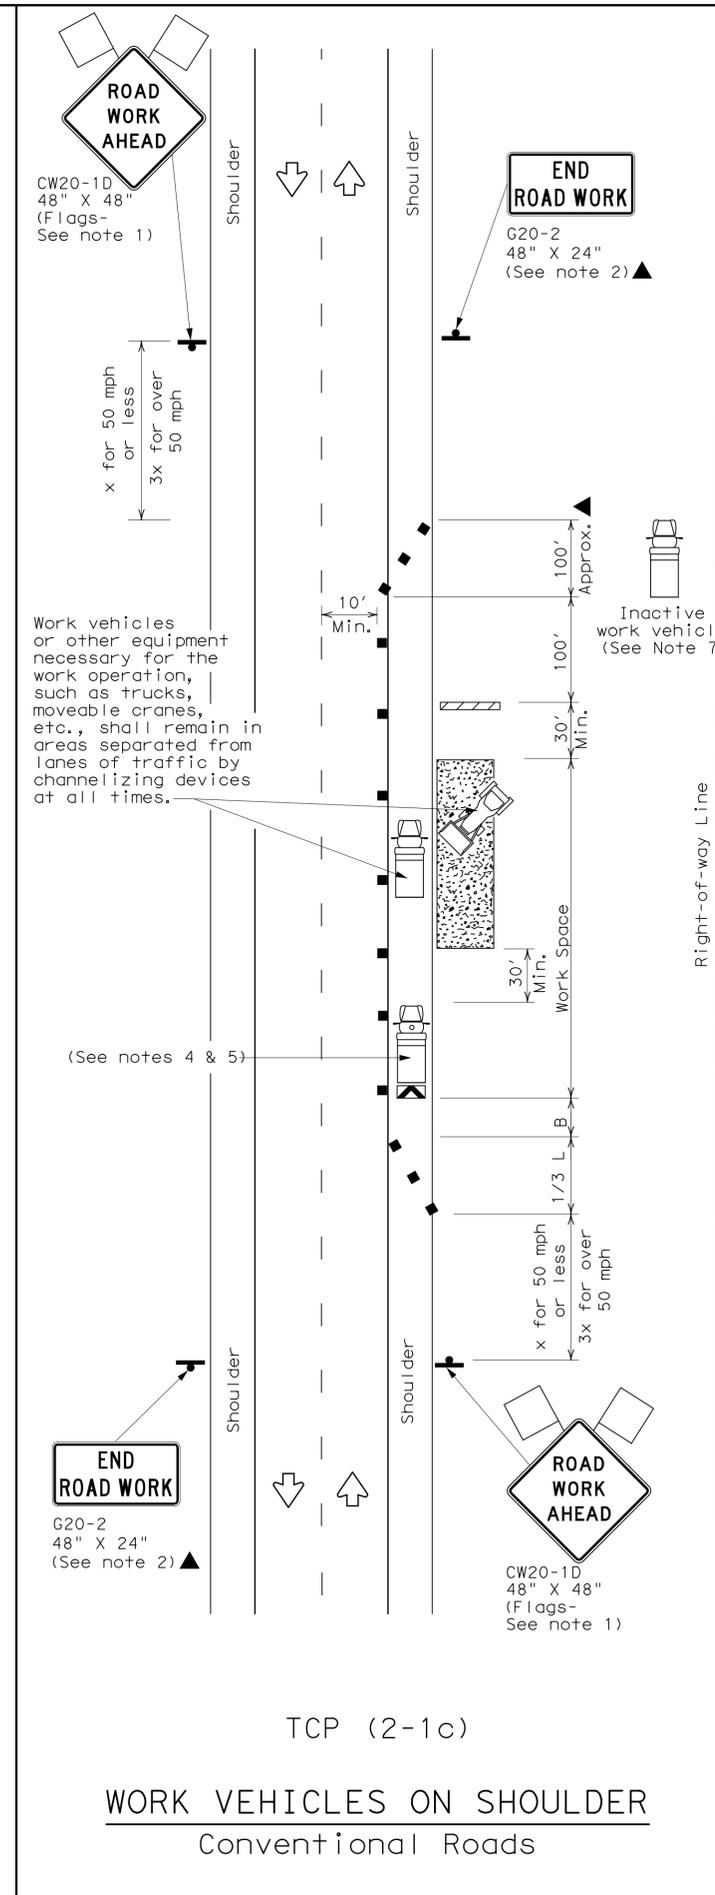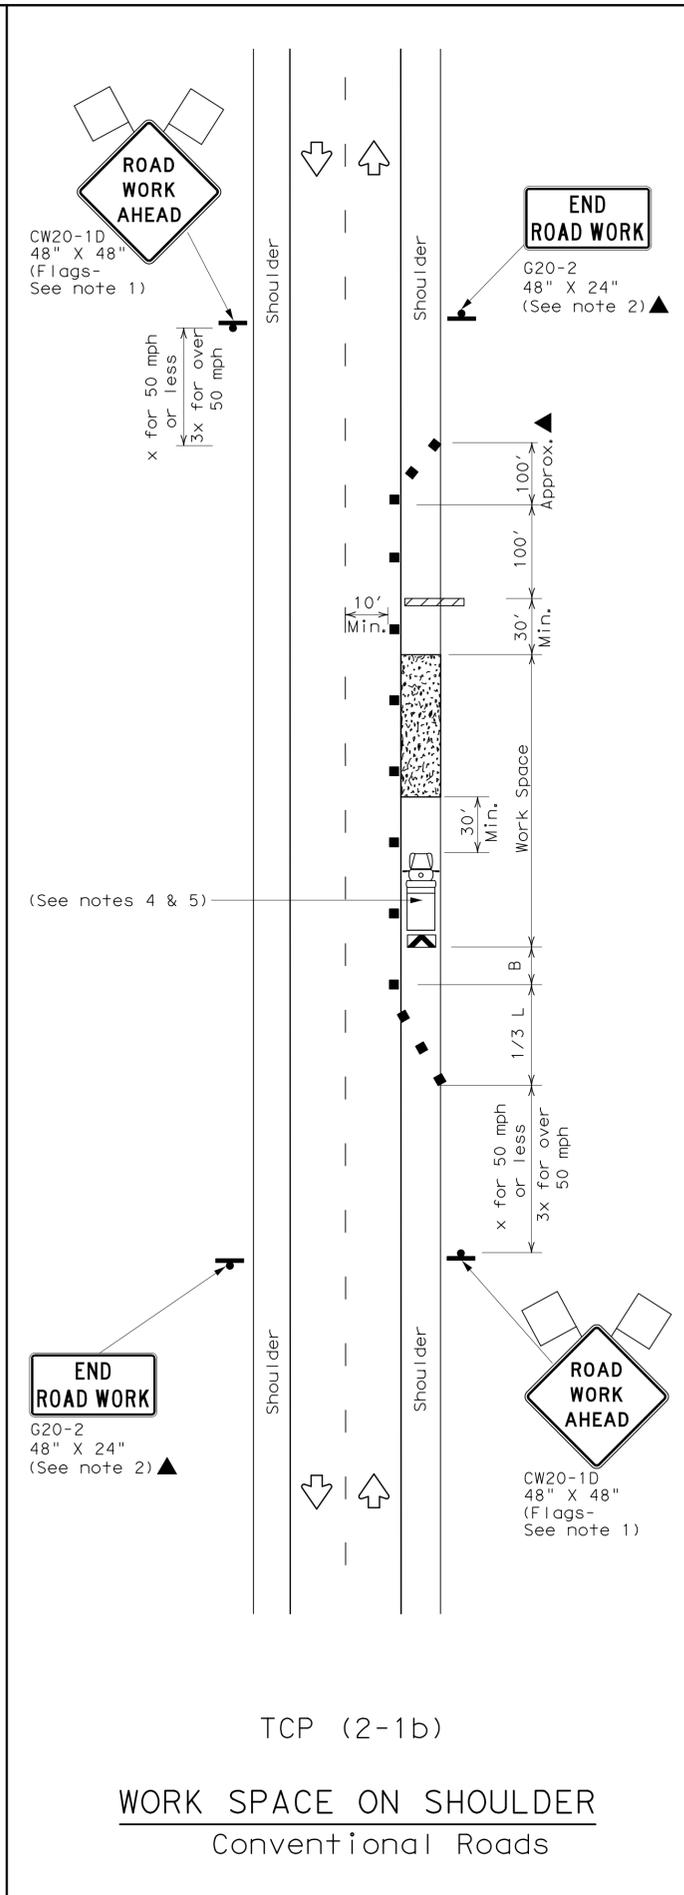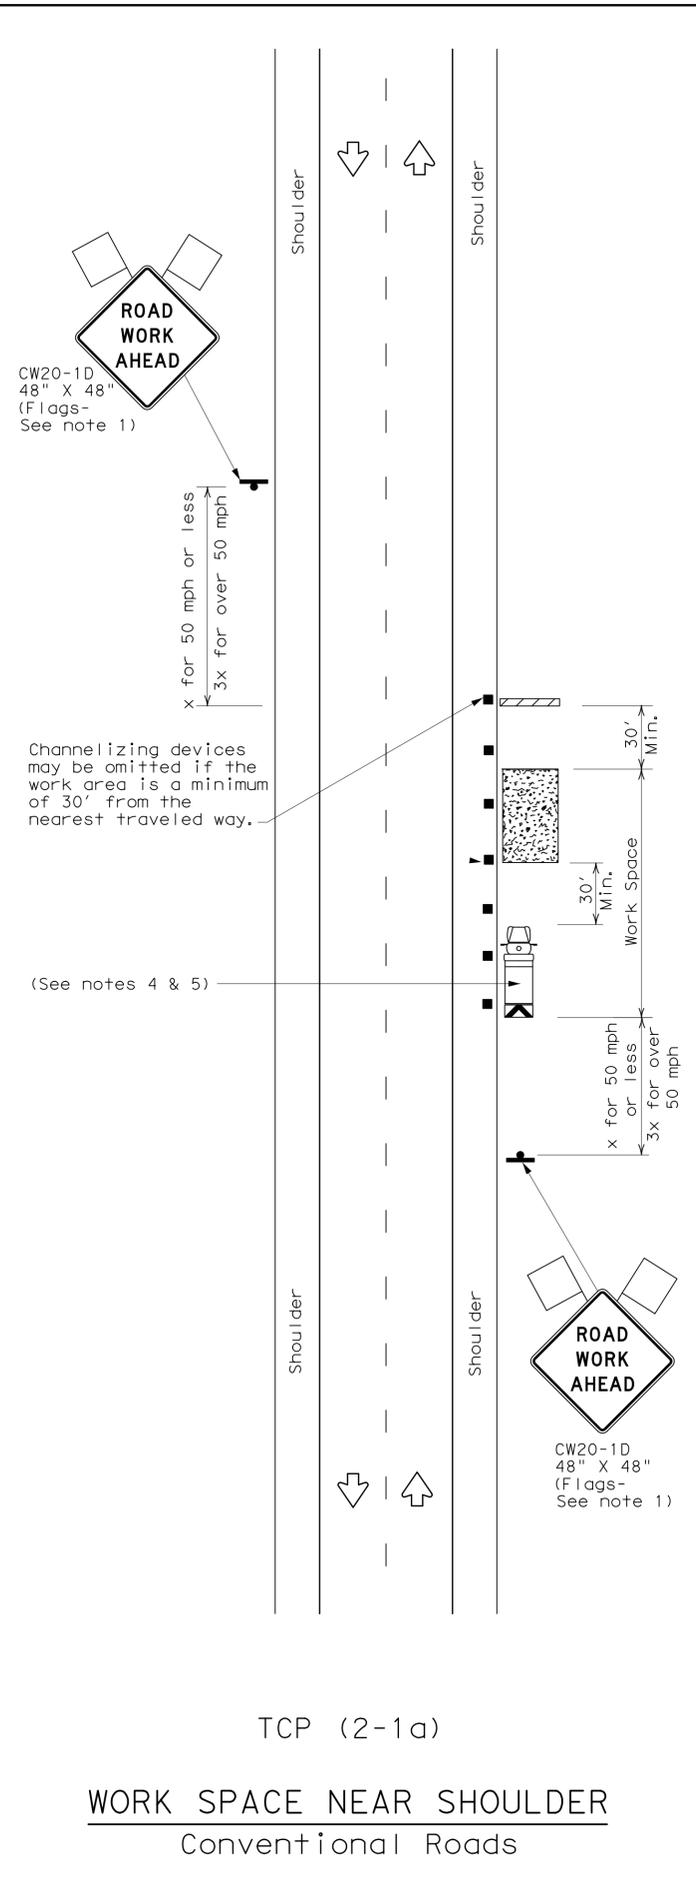

LEGEND			
	Type 3 Barricade		Channelizing Devices
	Heavy Work Vehicle		Truck Mounted Attenuator (TMA)
	Trailer Mounted Flashing Arrow Board		Portable Changeable Message Sign (PCMS)
	Sign		Traffic Flow
	Flag		Flagger

Posted Speed * X	Formula $L = \frac{WS^2}{60}$	Minimum Desirable Taper Lengths **			Suggested Maximum Spacing of Channelizing Devices		Minimum Sign Spacing "X" Distance	Suggested Longitudinal Buffer Space "B"
		10' Offset	11' Offset	12' Offset	On a Taper	On a Tangent		
30	$L = \frac{WS^2}{60}$	150'	165'	180'	30'	60'	120'	90'
35		205'	225'	245'	35'	70'	160'	120'
40		265'	295'	320'	40'	80'	240'	155'
45	$L = WS$	450'	495'	540'	45'	90'	320'	195'
50		500'	550'	600'	50'	100'	400'	240'
55		550'	605'	660'	55'	110'	500'	295'
60		600'	660'	720'	60'	120'	600'	350'
65		650'	715'	780'	65'	130'	700'	410'
70		700'	770'	840'	70'	140'	800'	475'
75		750'	825'	900'	75'	150'	900'	540'

* Conventional Roads Only
** Taper lengths have been rounded off.
L=Length of Taper (FT) W=Width of Offset (FT) S=Posted Speed (MPH)

TYPICAL USAGE				
MOBILE	SHORT DURATION	SHORT TERM STATIONARY	INTERMEDIATE TERM STATIONARY	LONG TERM STATIONARY
	✓	✓	✓	✓

- GENERAL NOTES**
- Flags attached to signs where shown, are REQUIRED.
 - All traffic control devices illustrated are REQUIRED, except those denoted with the triangle symbol may be omitted when stated in the plans, or for routine maintenance work, when approved by the Engineer.
 - Stockpiled material should be placed a minimum of 30 feet from nearest traveled way.
 - Shadow Vehicle with TMA and high intensity rotating, flashing, oscillating or strobe lights. A Shadow Vehicle with a TMA should be used anytime it can be positioned 30 to 100 feet in advance of the area of crew exposure without adversely affecting the performance or quality of the work. If workers are no longer present but road or work conditions require the traffic control to remain in place, Type 3 Barricades or other channelizing devices may be substituted for the Shadow Vehicle and TMA.
 - Additional Shadow Vehicles with TMAs may be positioned off the paved surface, next to those shown in order to protect a wider work space.
 - See TCP(5-1) for shoulder work on divided highways, expressways and freeways.
 - Inactive work vehicles or other equipment should be parked near the right-of-way line and not parked on the paved shoulder.
 - CW21-5 "SHOULDER WORK" signs may be used in place of CW21-1D "ROAD WORK AHEAD" signs for shoulder work on conventional roadways.

For construction or maintenance contract work, specific project requirements for shadow vehicles can be found in the project GENERAL NOTES for Item 502, Barricades, Signs and Traffic Handling.



**TRAFFIC CONTROL PLAN
CONVENTIONAL ROAD
SHOULDER WORK**

TCP (2-1) -12

© TxDOT December 1985		DN: TxDOT	CK: TxDOT	DW: TxDOT	CK: TxDOT
REVISIONS		CONT	SECT	JOB	HIGHWAY
2-94	2-12				
8-95					
1-97		DIST	COUNTY		SHEET NO.
4-98					D-9
161					